


CERTIFIED RECORD OF LAND CORNER MONUMENTATION

HISTORY OF ORIGINAL CORNER ESTABLISHED:

Corner originally established by Timothy Davenport under GLO contract number 102 dated July 20th, 1863. Surveyor General field notes state:
Set post corner to secs. 4, 5, 32, and 33.
Made mound of earth and drove charred stake as per inst.

In 1972 as part of Baker County Survey 7-40-3, James Hanley states: Reset 1/2" rebar from references.

T 7 S R 40 E Z-09

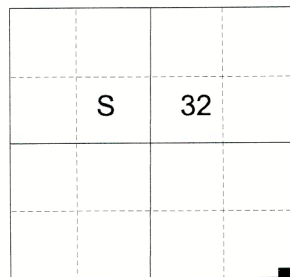

DESCRIPTION OF CORNER EVIDENCE FOUND:

Found a 4" hole in the asphalt surface of the intersection of Coffey Road and Colton Road. Excavated 14" below the asphalt surface. Magnetic location indicates possible ferrous material approx. 2 ft. deeper. Approximate position falls very near to the position computed by ties to adjacent monuments. To retrieve the any possible iron pin, it was determined would cause undue harm to the roadway.


DESCRIPTION OF MONUMENT AND ACCESSORIES I ESTABLISHED TO MONUMENT THE ORIGINAL LOCATION OF THIS CORNER:

At position determined by survey I set a 5/8" x 30" iron pin, flush with the road surface, with 2" brass cap, marked as shown, from which:

NEW BEARING OBJECTS:

- A power pole bears North 81°45' East a dist. of 182.01 ft., marked with pole number 102330401.
- A 3" angle iron fence corner to South and East bearing fences, of which the Northwest corner bears South 53°46' East a dist. of 52.28 ft.
- A power pole bears South 17°11' West a dist. of 167.15 ft., marked with pole number 1120599991 as well as K10126-40KS.
- A power pole bears North 11°59' West a dist. of 24.47 ft., marked with pole number 102329901.

I hereby certify that the corner was monumented on December 14, 2021.
Witness: Kyle A. Tucker

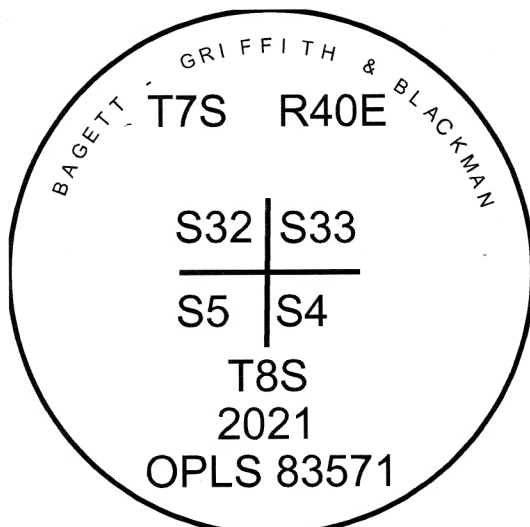

Renewal Date: June 30, 2023

I used a Leica GS 18 with tilt compensation in the establishment of the new accessories. Basis of Bearing is as per survey for Trevor Collins dated December 2021. Bearings and distances of the power poles are to a brass washer labeled "OPLS 83571" on the side facing the monument. Bearing and distance of the fence corner is to the Northwesterly corner of the angle iron at the point it enters it's concrete base.

Z-09

FILED January 26, 2022
BAKER COUNTY SURVEYOR
SURVEY NO. 7-40-23
8-40-47