


T. 9 S., R. 39 E. W.M.

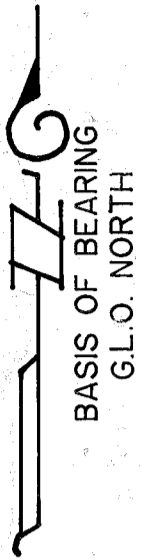

FOUND C-1/4 MONUMENT SEC. 6
1-3/8 INCH SMOOTH PIN

AS-BUILT

1902 SURVEY

N 1/2 LOT I OF THE SW 1/4

NARRATIVE

THIS SURVEY OF A PART OF THE MARBLE CREEK ROAD IS MADE AT REQUEST OF BAKER COUNTY ROAD DEPARTMENT. THE EXISTING ROAD IS SHOWN HEREON FROM THE C-1/4 CORNER OF SECTION 6, T. 9 S., R. 39 E., W.M. TO THE CROSSING OF THE BAISLEY DITCH IN THE S. 1/2 GOV'T. LOT I OF THE SW 1/4 (SE 1/4 SW 1/4) OF SECTION 6. THE SURVEYED PART OF THIS ROAD IS SHOWN HEREON WITH SOLID LINES 60 FEET WIDTH. SHOWN ON THIS DRAWING IS THE SUPERIMPOSED ROADWAY DESCRIBED BY COUNTY SURVEYOR D.W.C. NELSON, APPROVED JUNE 4, 1902, BY COUNTY ROAD VIEWERS. A COPY OF THE APPROVED DESCRIPTION IS ATTACHED.

NOTE:

THIS DRAWING SHOWS ROADWAY PER SURVEY OF 1902 AND AS-BUILT SECTION OF A PART OF THE MARBLE CREEK ROAD, SURVEYED JUNE 17, 1996.

LEGEND

⊙ - FOUND MONUMENT AS NOTED

PER DESCRIPTION BY COUNTY SURVEYOR.
APPROVED BY ROAD VIEWERS JUNE 4, 1902.

AS-BUILT

S. 24° W. 20.00 CH.

S. 60° W. 5.39 CH.

S. 55° W. 2.14 CH.

S. 43-1/2° W. 6.00 CH.

TERMINUS OF CO. RD.
IS AT BAISLEY DITCH

S 1/2 LOT I OF THE SW 1/4

MAP OF SURVEY

A PART OF MARBLE CREEK ROAD
SURVEYED JUNE 17, 1996
SCALE: 1"=200'

HANLEY ENGINEERING
2043 MAIN STREET
BAKER CITY, OREGON

FILED 7-03-96
BAKER COUNTY SURVEYOR
SURVEY NO. 9-39-268

REGISTERED
PROFESSIONAL
LAND SURVEYOR

James D. Hanley

OREGON
SEPTEMBER 23, 1977
JAMES D. HANLEY
1206

RENEWS JUNE-30, 1997