


TOWNSHIP 12 S., RANGE 44 E.W. M.

PAGE 75

SCALE 2 IN. = 1 MILE

DATED 1933

CHAS. F. METSKER, CIVIL ENGINEER
215 COMMERCE BLDG., PORTLAND, OREGON
930 PACIFIC AVE., TACOMA, WASHINGTON

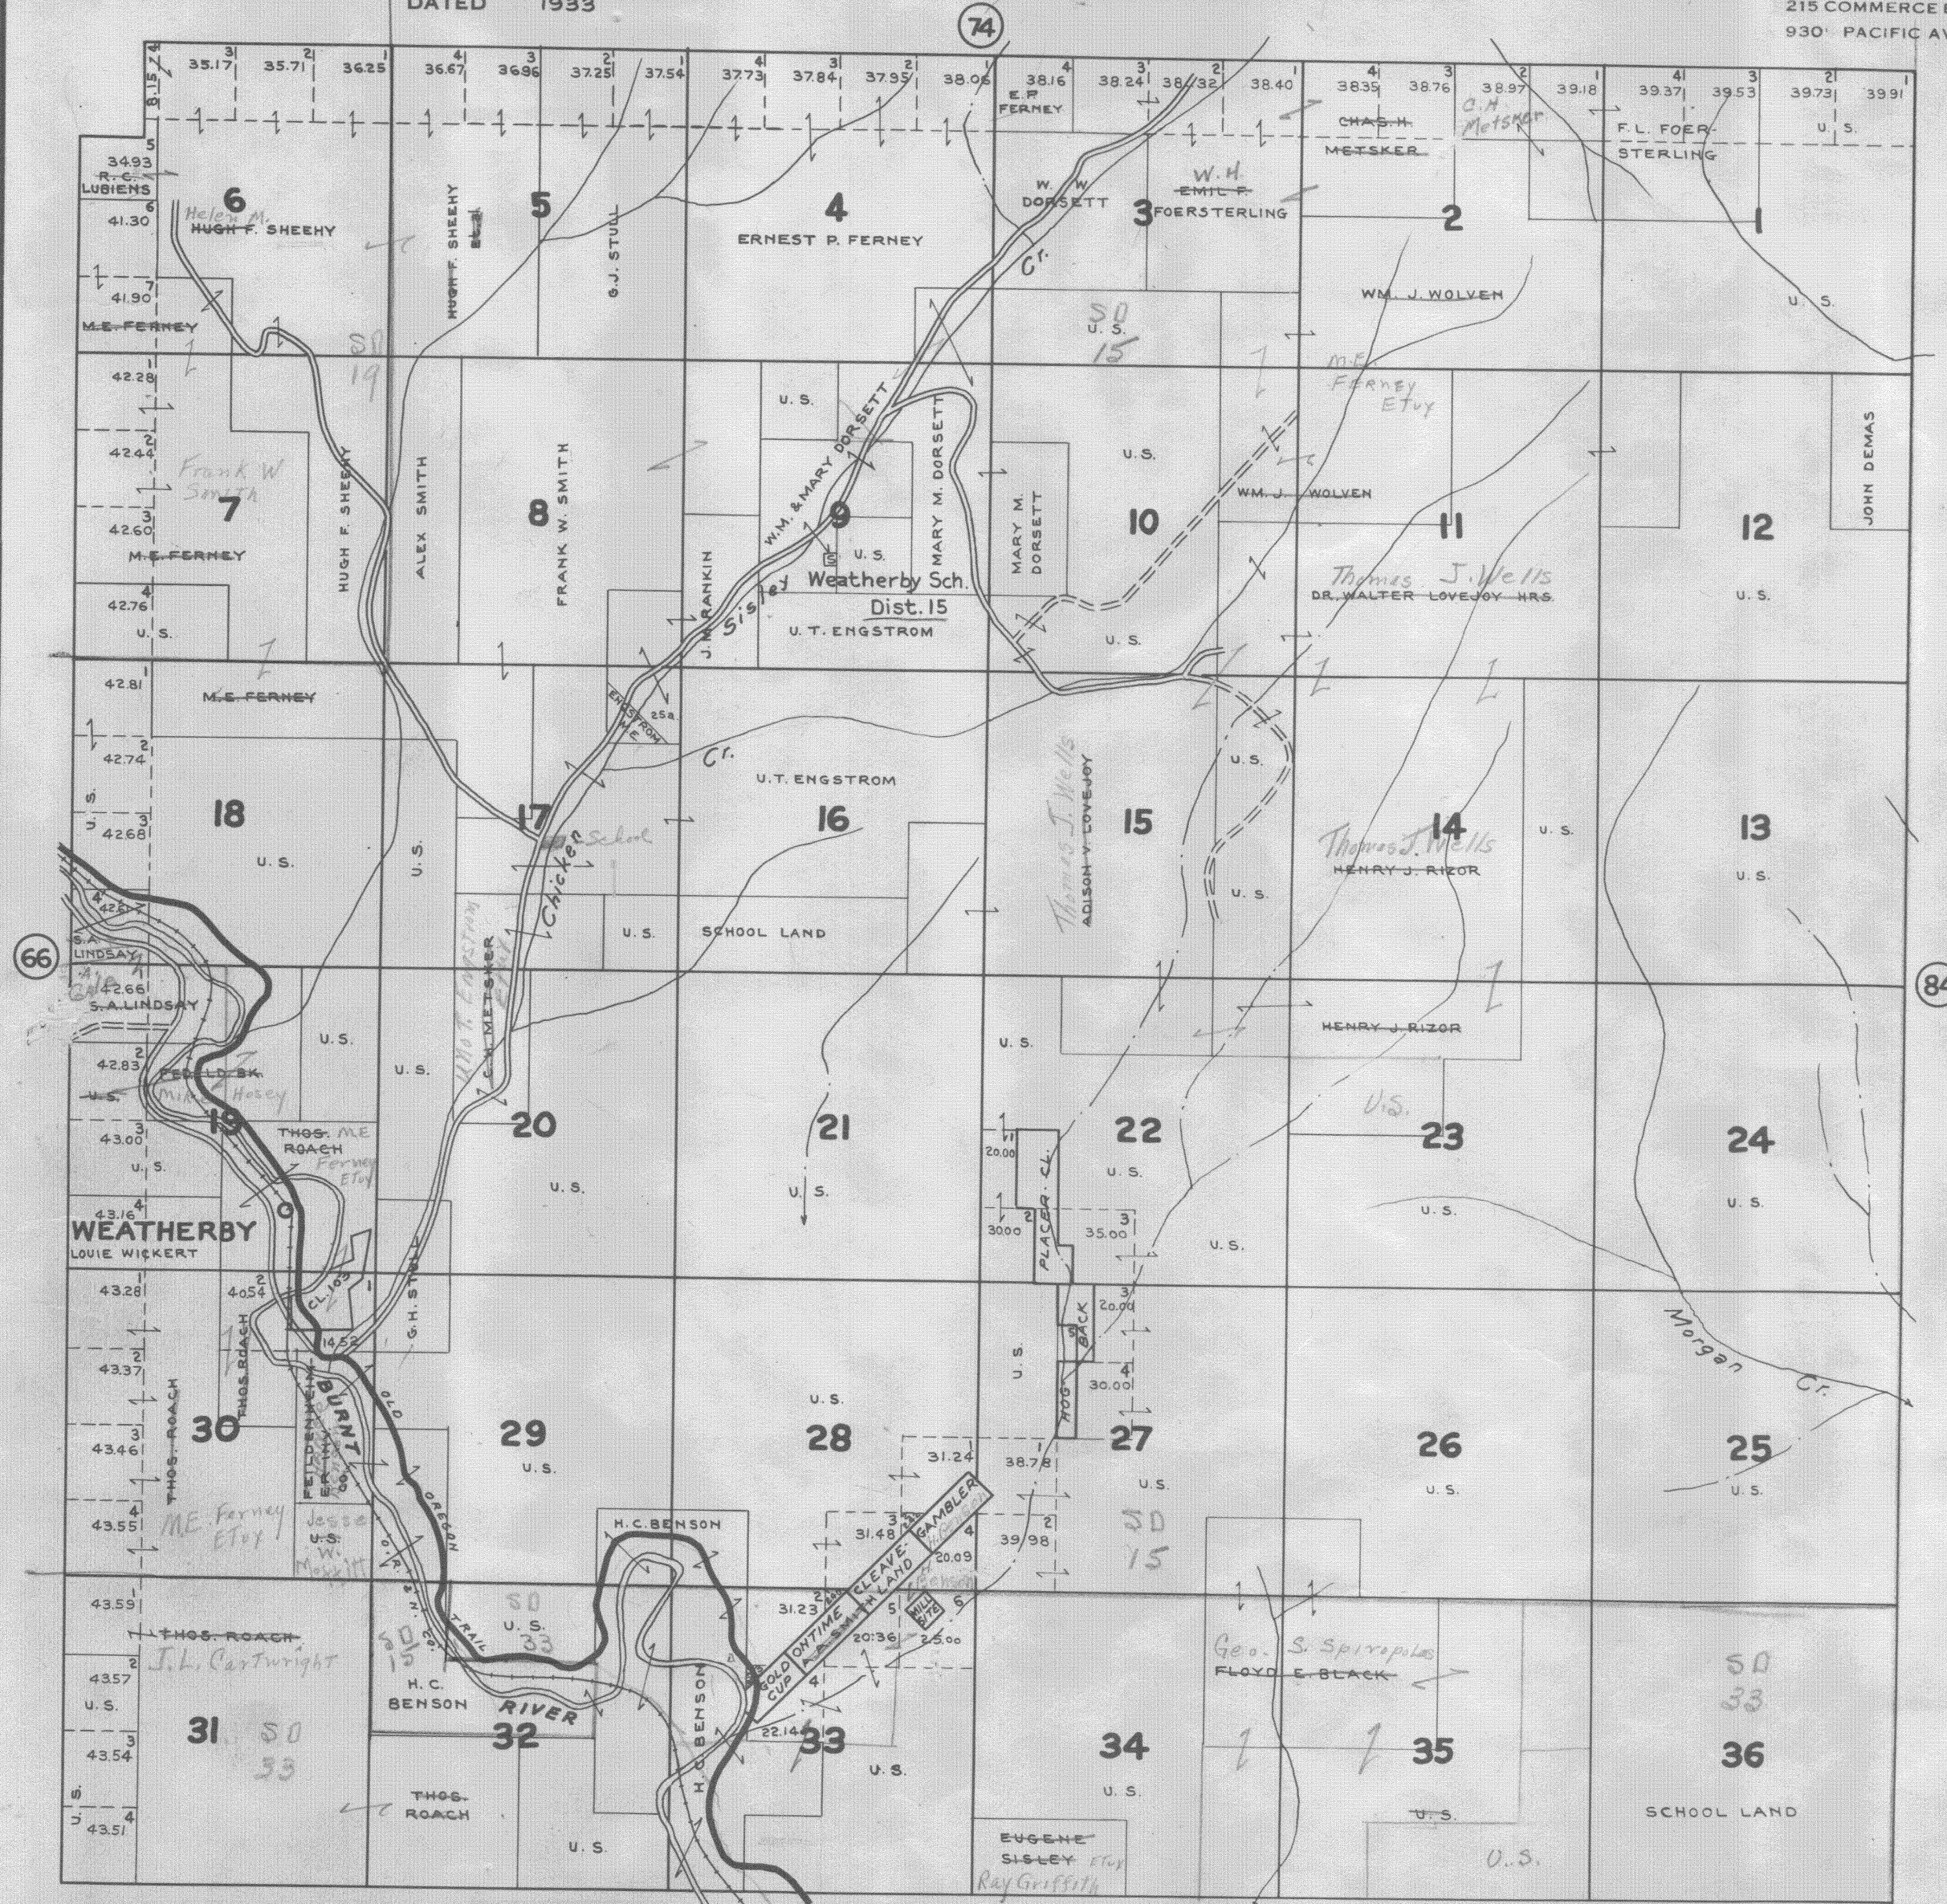

COPYRIGHT BY CHAS. F. METSKER

—LEGEND—

PAVED ROADS	
STATE HIGHWAYS	
GRAVELED ROADS	
DIRT ROADS	
INFERIOR ROADS	
RAILROADS	
TRAILS	
INTERMITTENT CREEKS	
SCHOOLS	