

TOWNSHIP 7 S., RANGE 45 E.W. M.

PAGE 79


SCALE 2 IN. = 1 MILE

DATED 1933

BAKER COUNTY, OREGON

CHAS. F. METSKER, CIVIL ENGINEER
215 COMMERCE BLDG., PORTLAND, OREGON
9301 PACIFIC AVE., TACOMA, WASHINGTON

- 1-D.J. ALSTEADT
- 2-ALMA PAINTER
- 3-MERRILL PAINTER
- 4-CARL INGRAM
- 5-ALICE MILLS
- 6-HENRY THOMPSON John Thaysen
- 7-Claude Martin
- 8-Louise Thompson

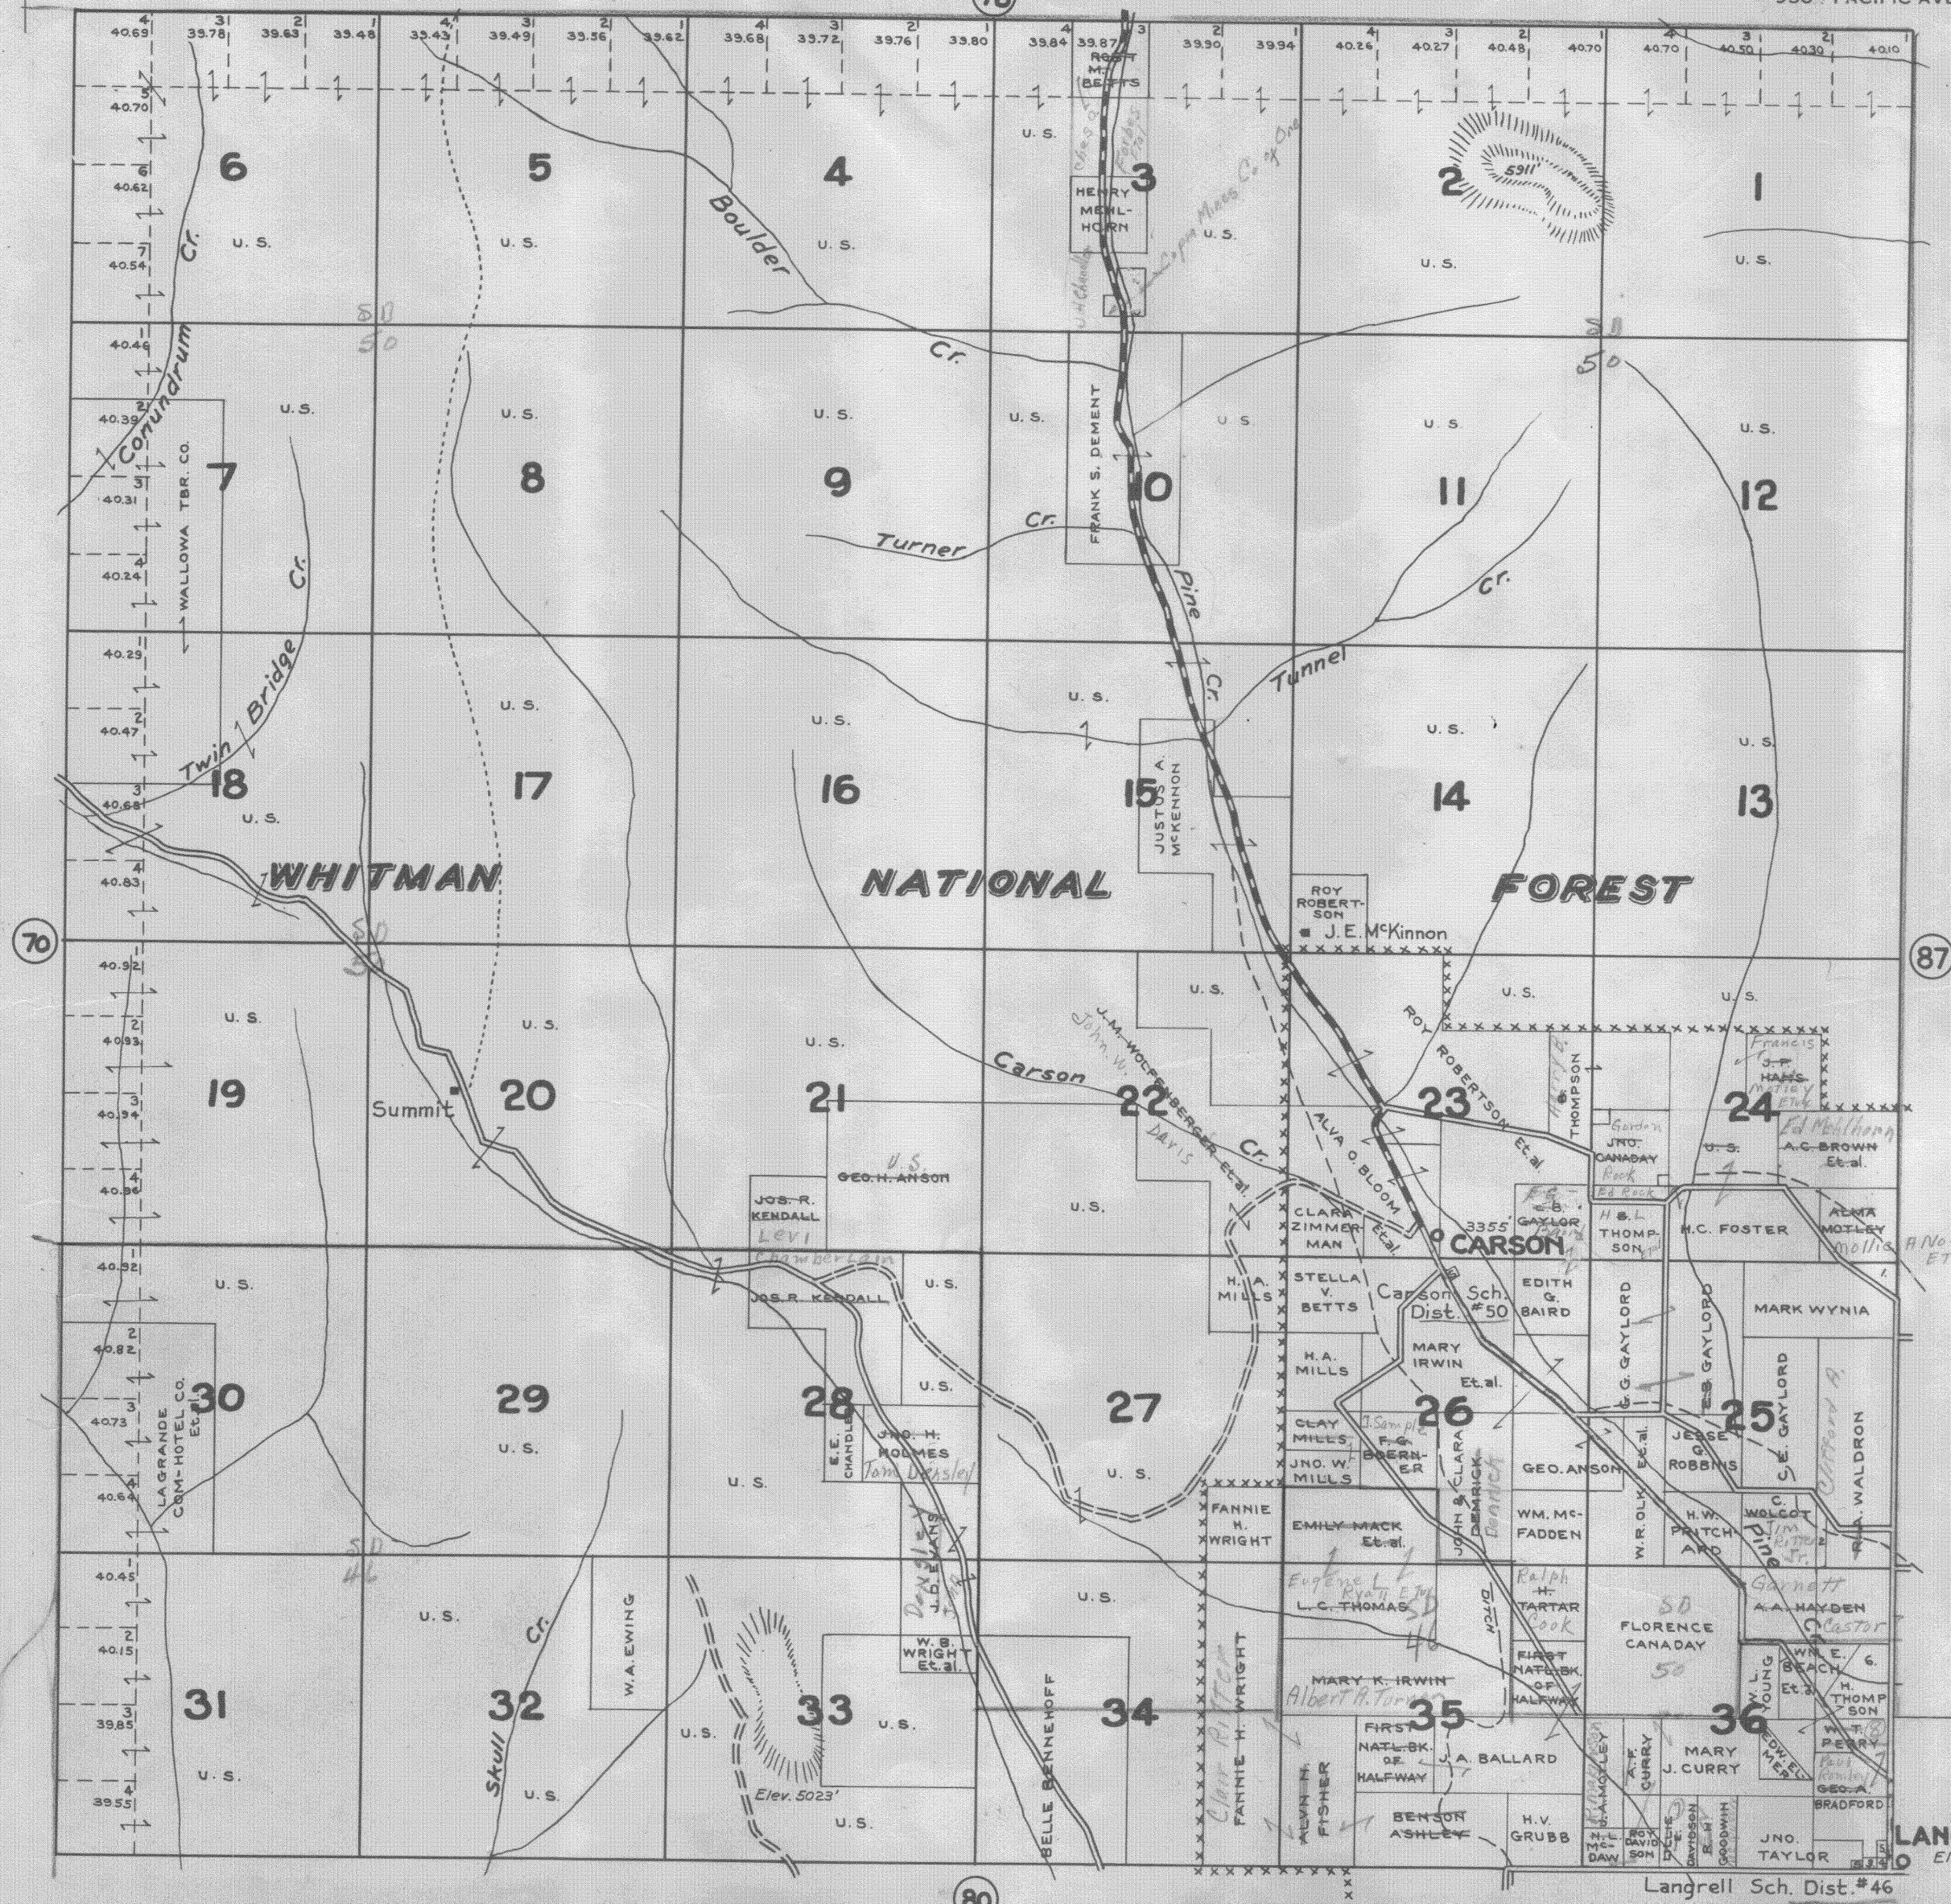

—LEGEND—

- PAVED ROADS
- STATE HIGHWAYS
- GRAVELED ROADS
- DIRT ROADS
- INFERIOR ROADS
- RAILROADS
- TRAILS
- INTERMITTENT CREEKS
- SCHOOLS