

TOWNSHIP 8 S., RANGE 45 E.W. M.


BAKER COUNTY, OREGON

SCALE 2 IN. = 1 MILE

DATED 1933

CHAS. F. METSKER, CIVIL ENGINEER
215 COMMERCE BLDG., PORTLAND, OREGON
930 1/2 PACIFIC AVE., TACOMA, WASHINGTON

1. S. T. Grantham
2. M. Cooper

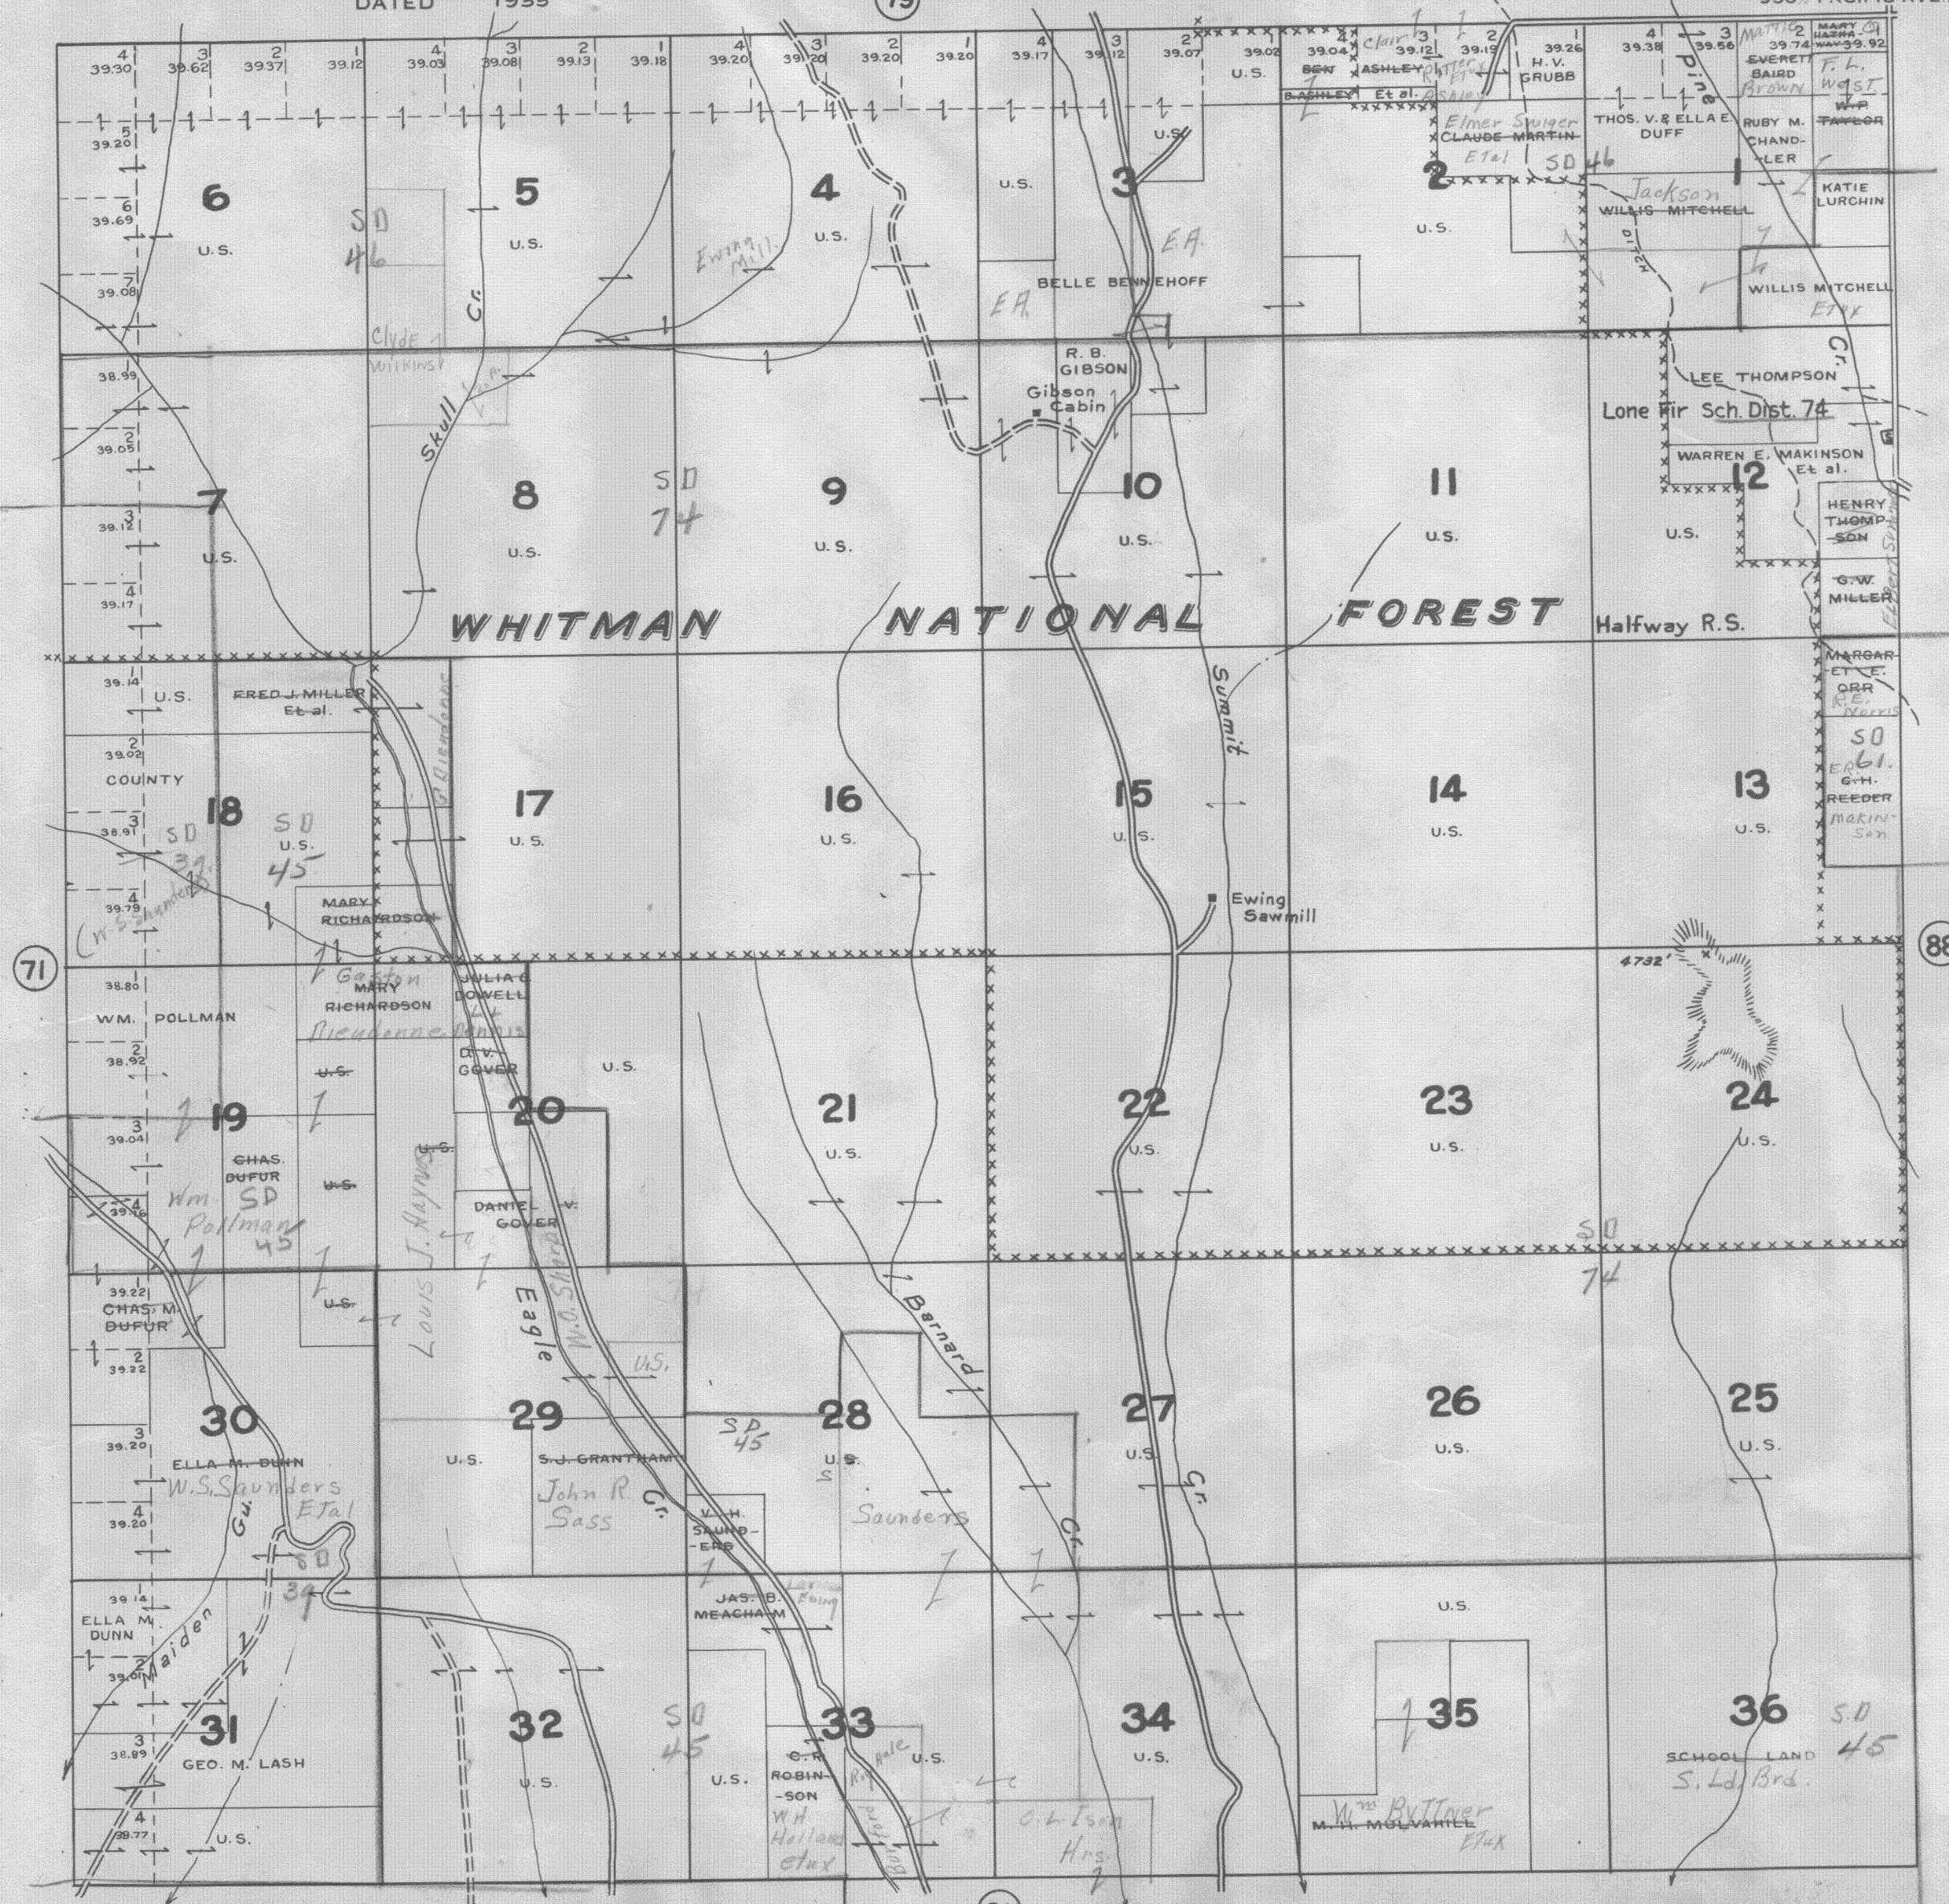

- LEGEND—
- PAVED ROADS
 - STATE HIGHWAYS
 - GRAVELED ROADS
 - DIRT ROADS
 - INFERIOR ROADS
 - RAILROADS
 - TRAILS
 - INTERMITTENT CREEKS
 - SCHOOLS