


TOWNSHIP 11 S., RANGE 45 E.W.M.
BAKER COUNTY, OREGON

PAGE 83

SCALE 2 IN. = 1 MILE

DATED 1933

CHAS. F. METSKER, CIVIL ENGINEER
215 COMMERCE BLDG., PORTLAND, OREGON
930 PACIFIC AVE., TACOMA, WASHINGTON

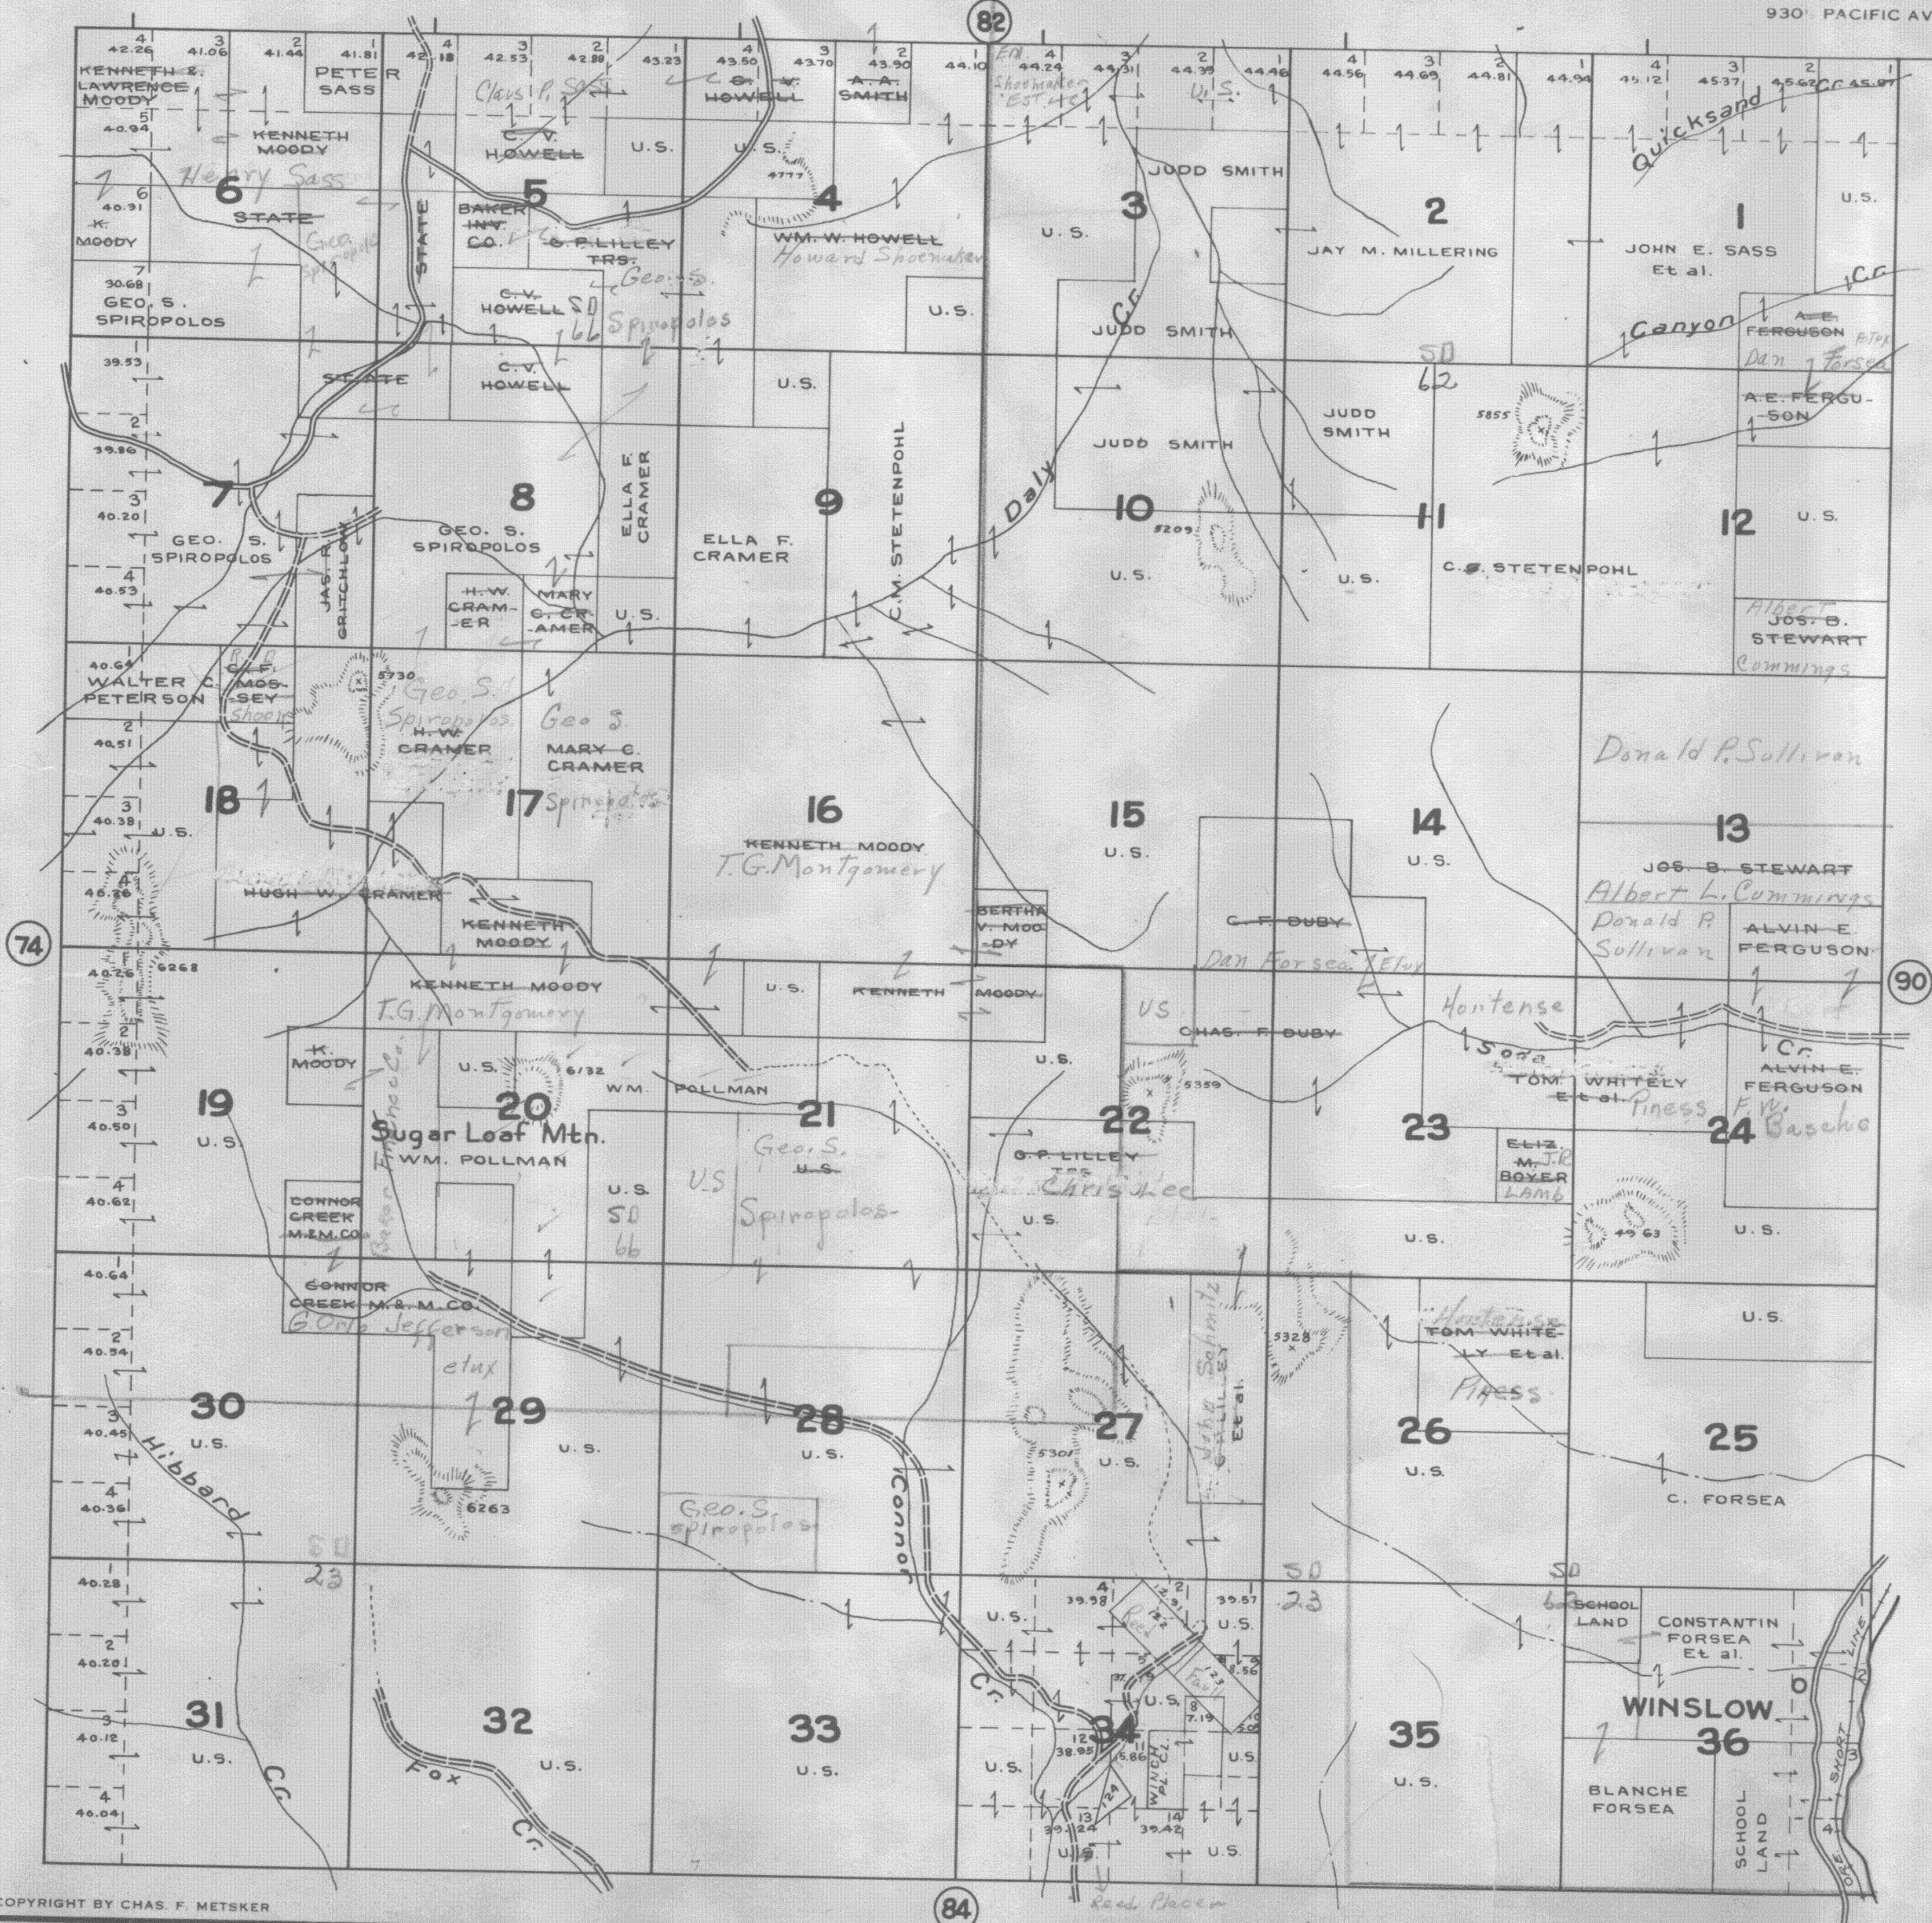

—LEGEND—

- PAVED ROADS
- STATE HIGHWAYS
- GRAVELED ROADS
- DIRT ROADS
- INFERIOR ROADS
- RAILROADS
- TRAILS
- INTERMITTENT CREEKS
- SCHOOLS