OREGON STATE HIGHWAY DEPARTMENT

RELOCATED LINE

DURKEE-GALES SECTION

OLD OREGON TRAIL HIGHWAY

BAKER COUNTY

Scale 1"=100' Sept. 1931
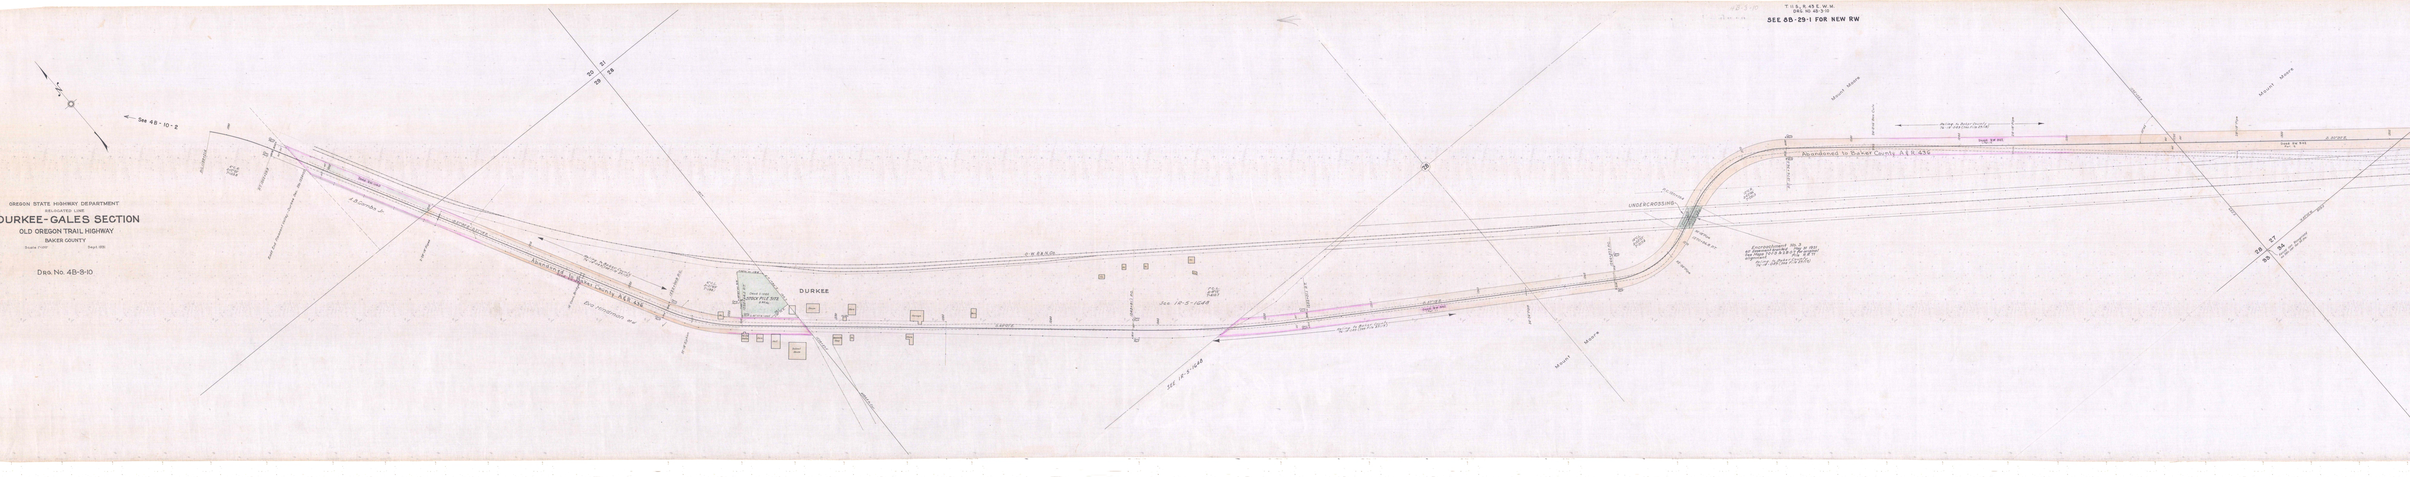
Dwg. No. 4B-9-10