


OREGON STATE HIGHWAY DEPARTMENT
FAREWELL BEND PARK
OLD OREGON TRAIL HIGHWAY
BAKER COUNTY
Scale: 1 inch = 400 ft.
Traced by M.L.J. Oct., 1963
Rev. Nov., 2000
GRID BEARINGS-NORTH ZONE
DRG. NO. 8B-29-10

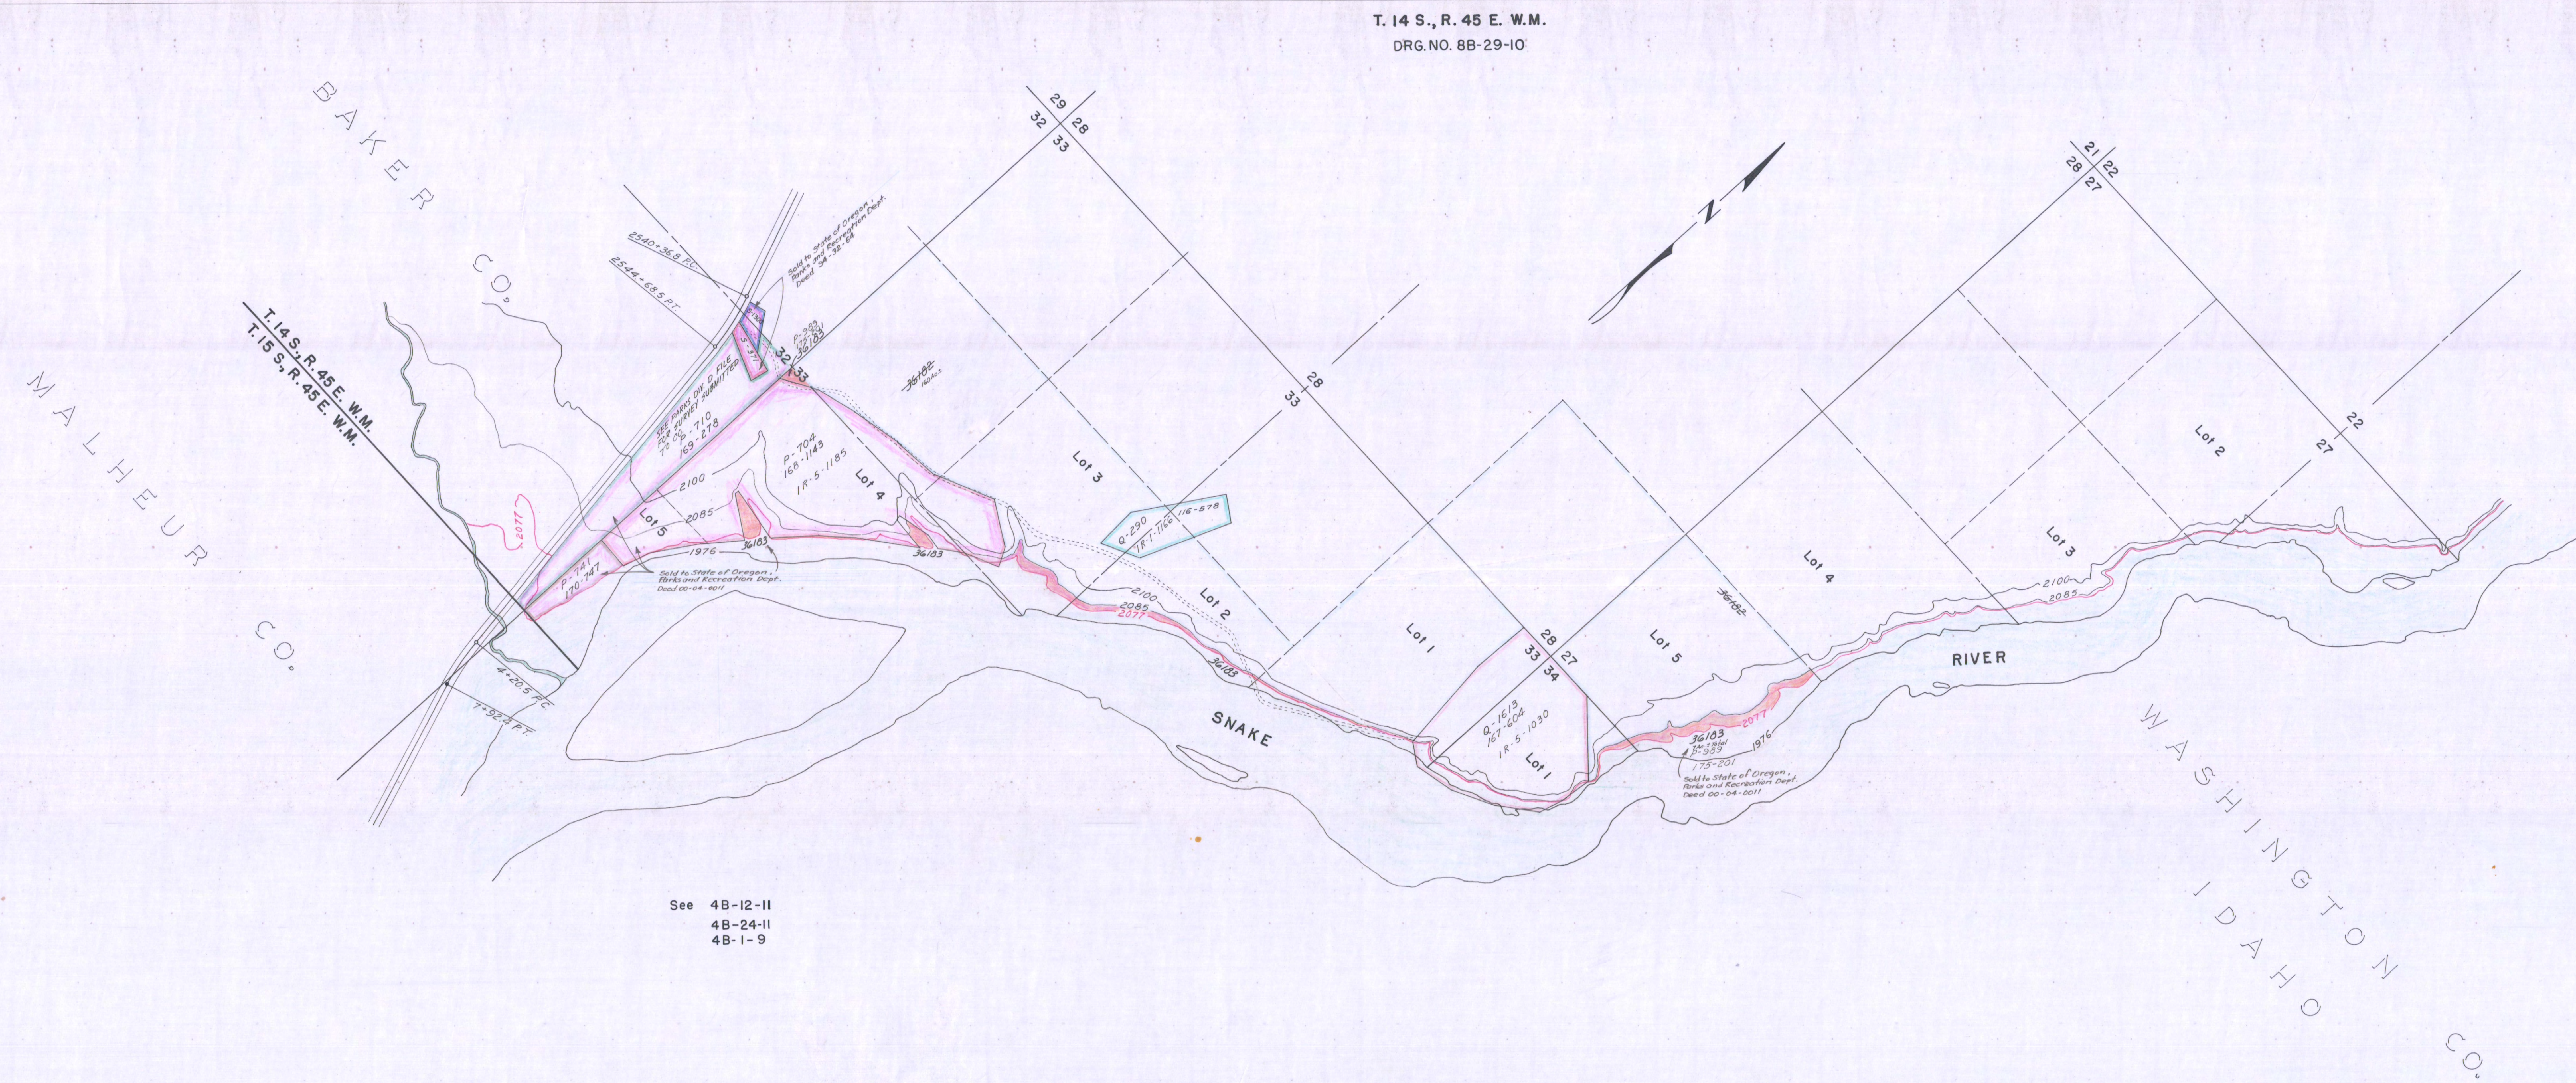

FAREWELL BEND PARK
OLD OREGON TRAIL HIGHWAY
BAKER COUNTY
SCALE: 1" = 400'
OCTOBER, 1963
DRG. NO. 8B-29-10