


OREGON STATE HIGHWAY DIVISION
Located Line
POWDER RIVER SECTION
WHITNEY HIGHWAY
BAKER COUNTY


Scale: 1 inch = 100 feet
Traced by R.D.S. July, 1980 Revised: Aug. 1980
: Dec. 1980
: Aug. 1981
GRID BEARINGS-NORTH ZONE
DRG. NO. 9B-17-20

NOTE: Monuments indicated were found and tied between
10/7/79 and 11/7/79.

- o Found Mon. - As Noted
- o Set Rod Indicates - Set $\frac{3}{8}$ " x 30" Iron Rod with O.S.H.D. Alum. Cap.

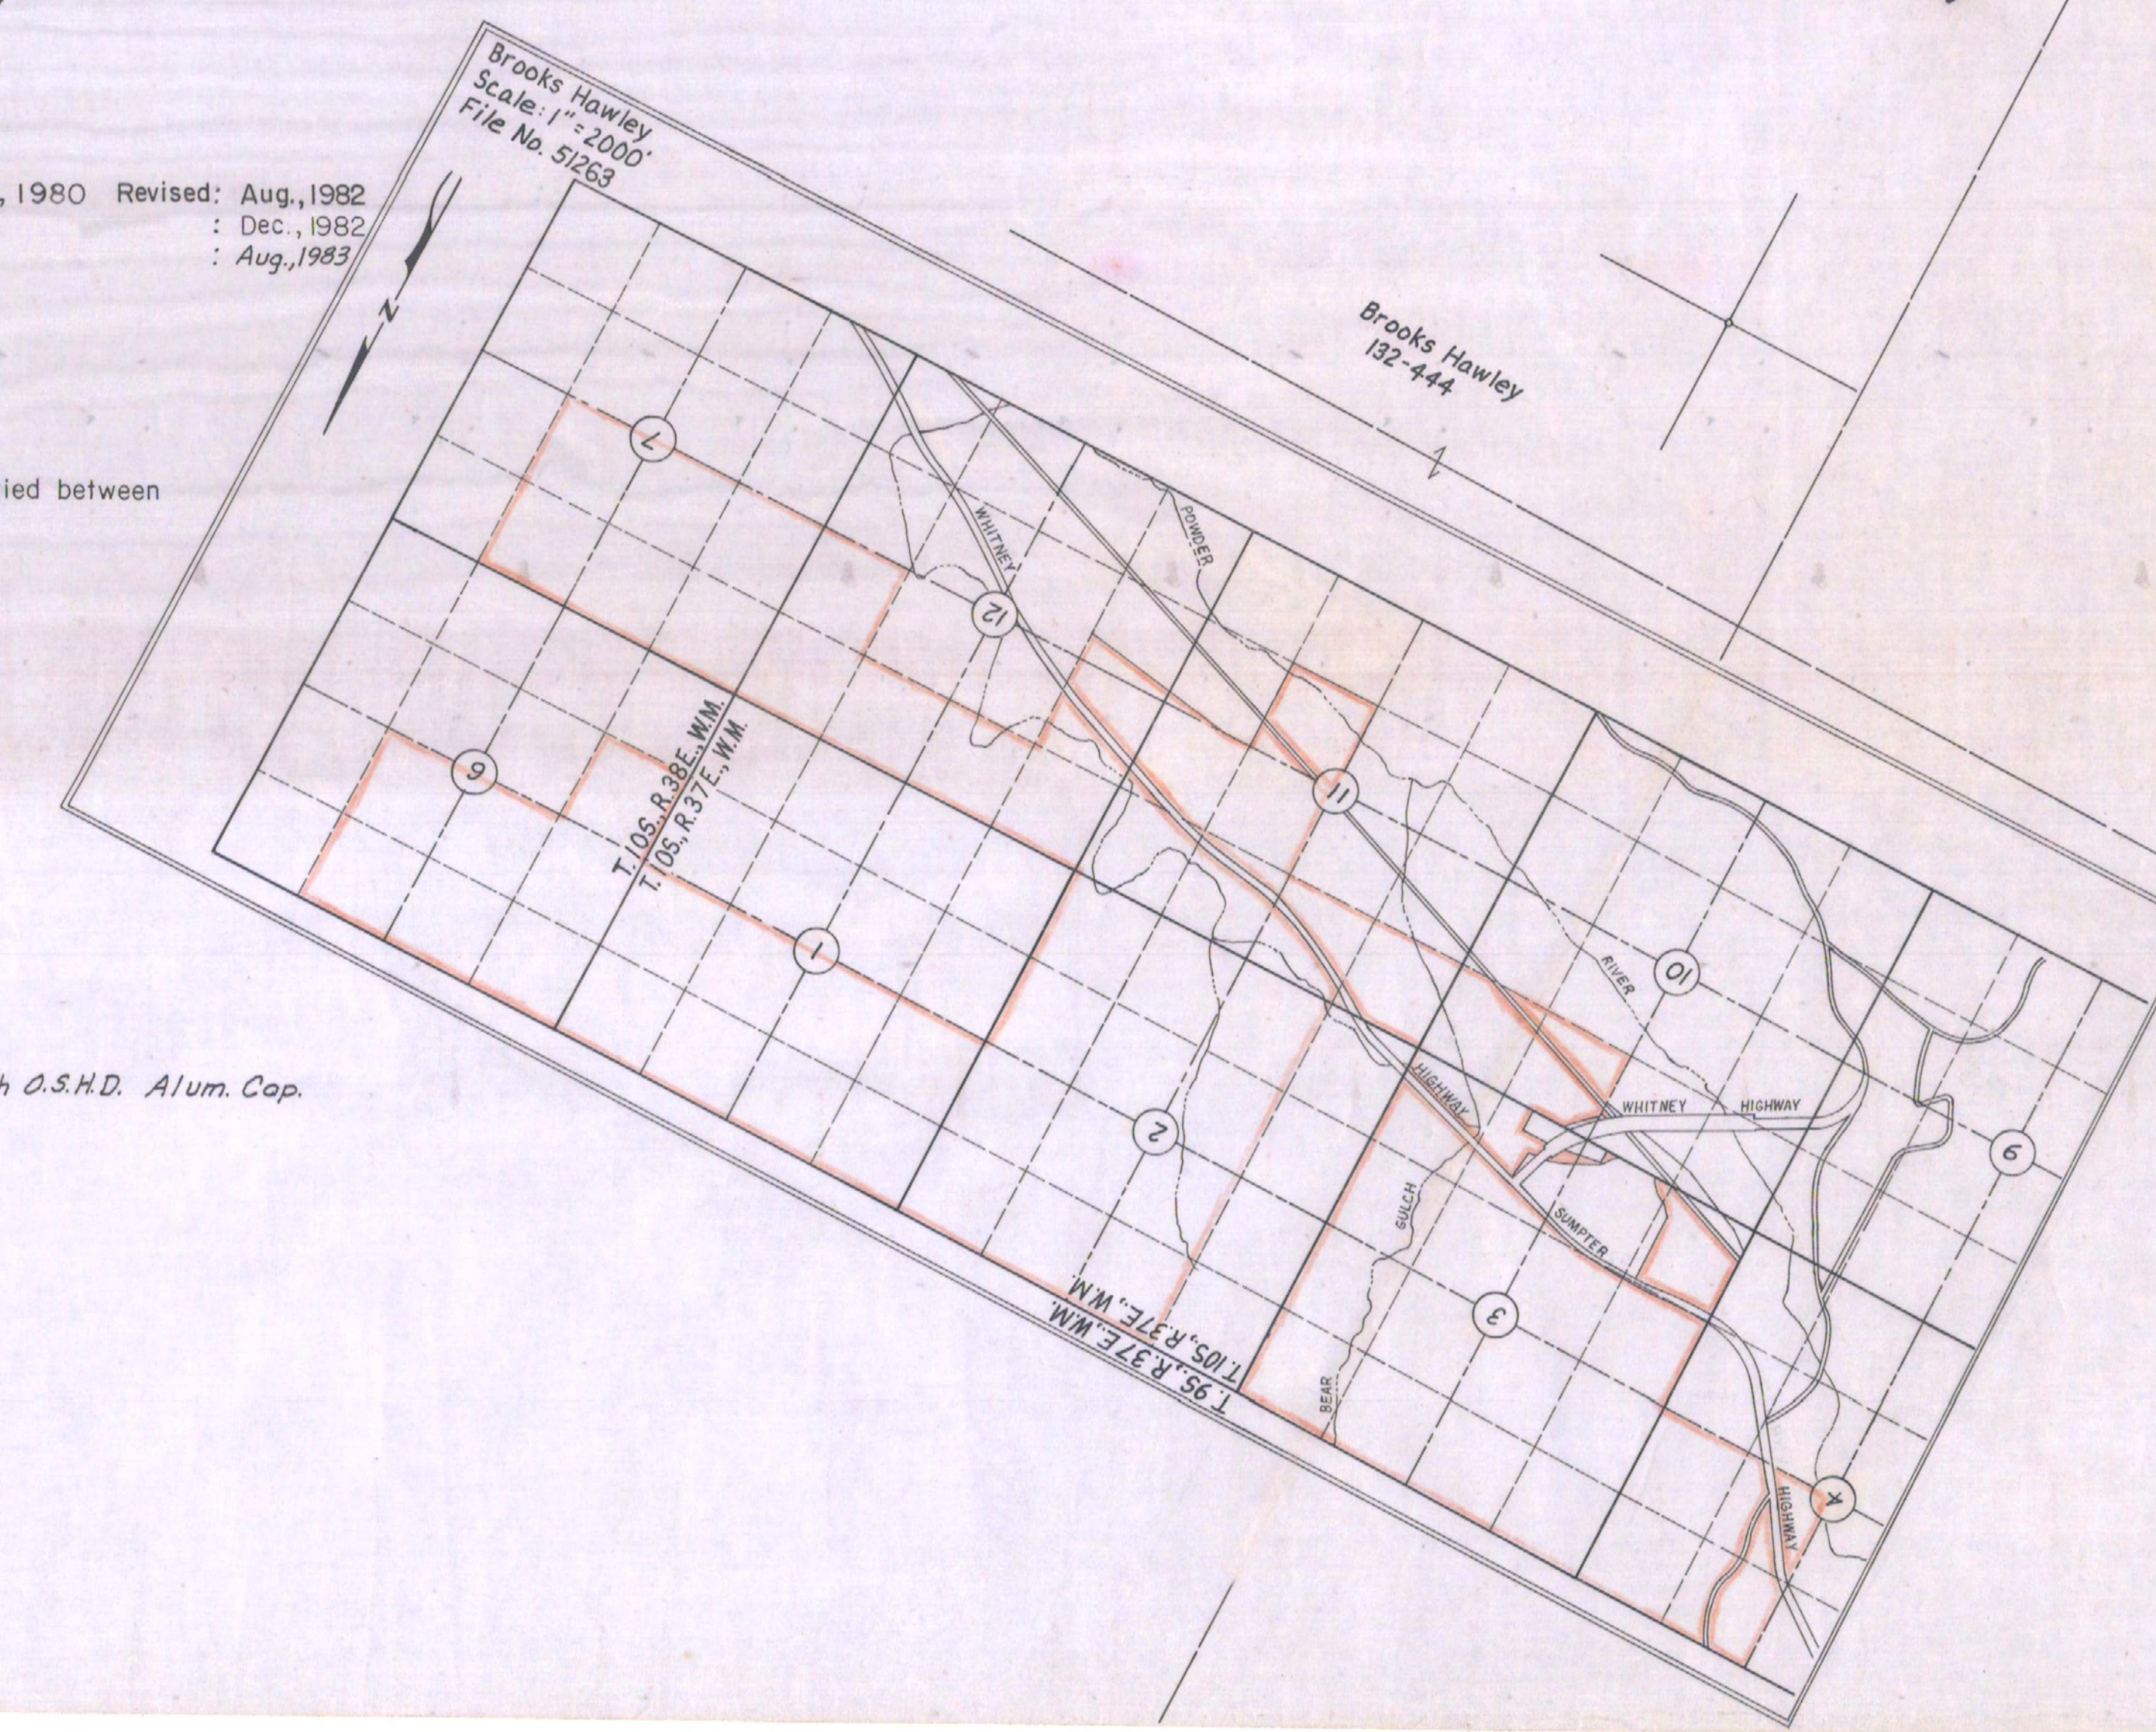

SEE 9B-16-13 FOR PRIOR RW

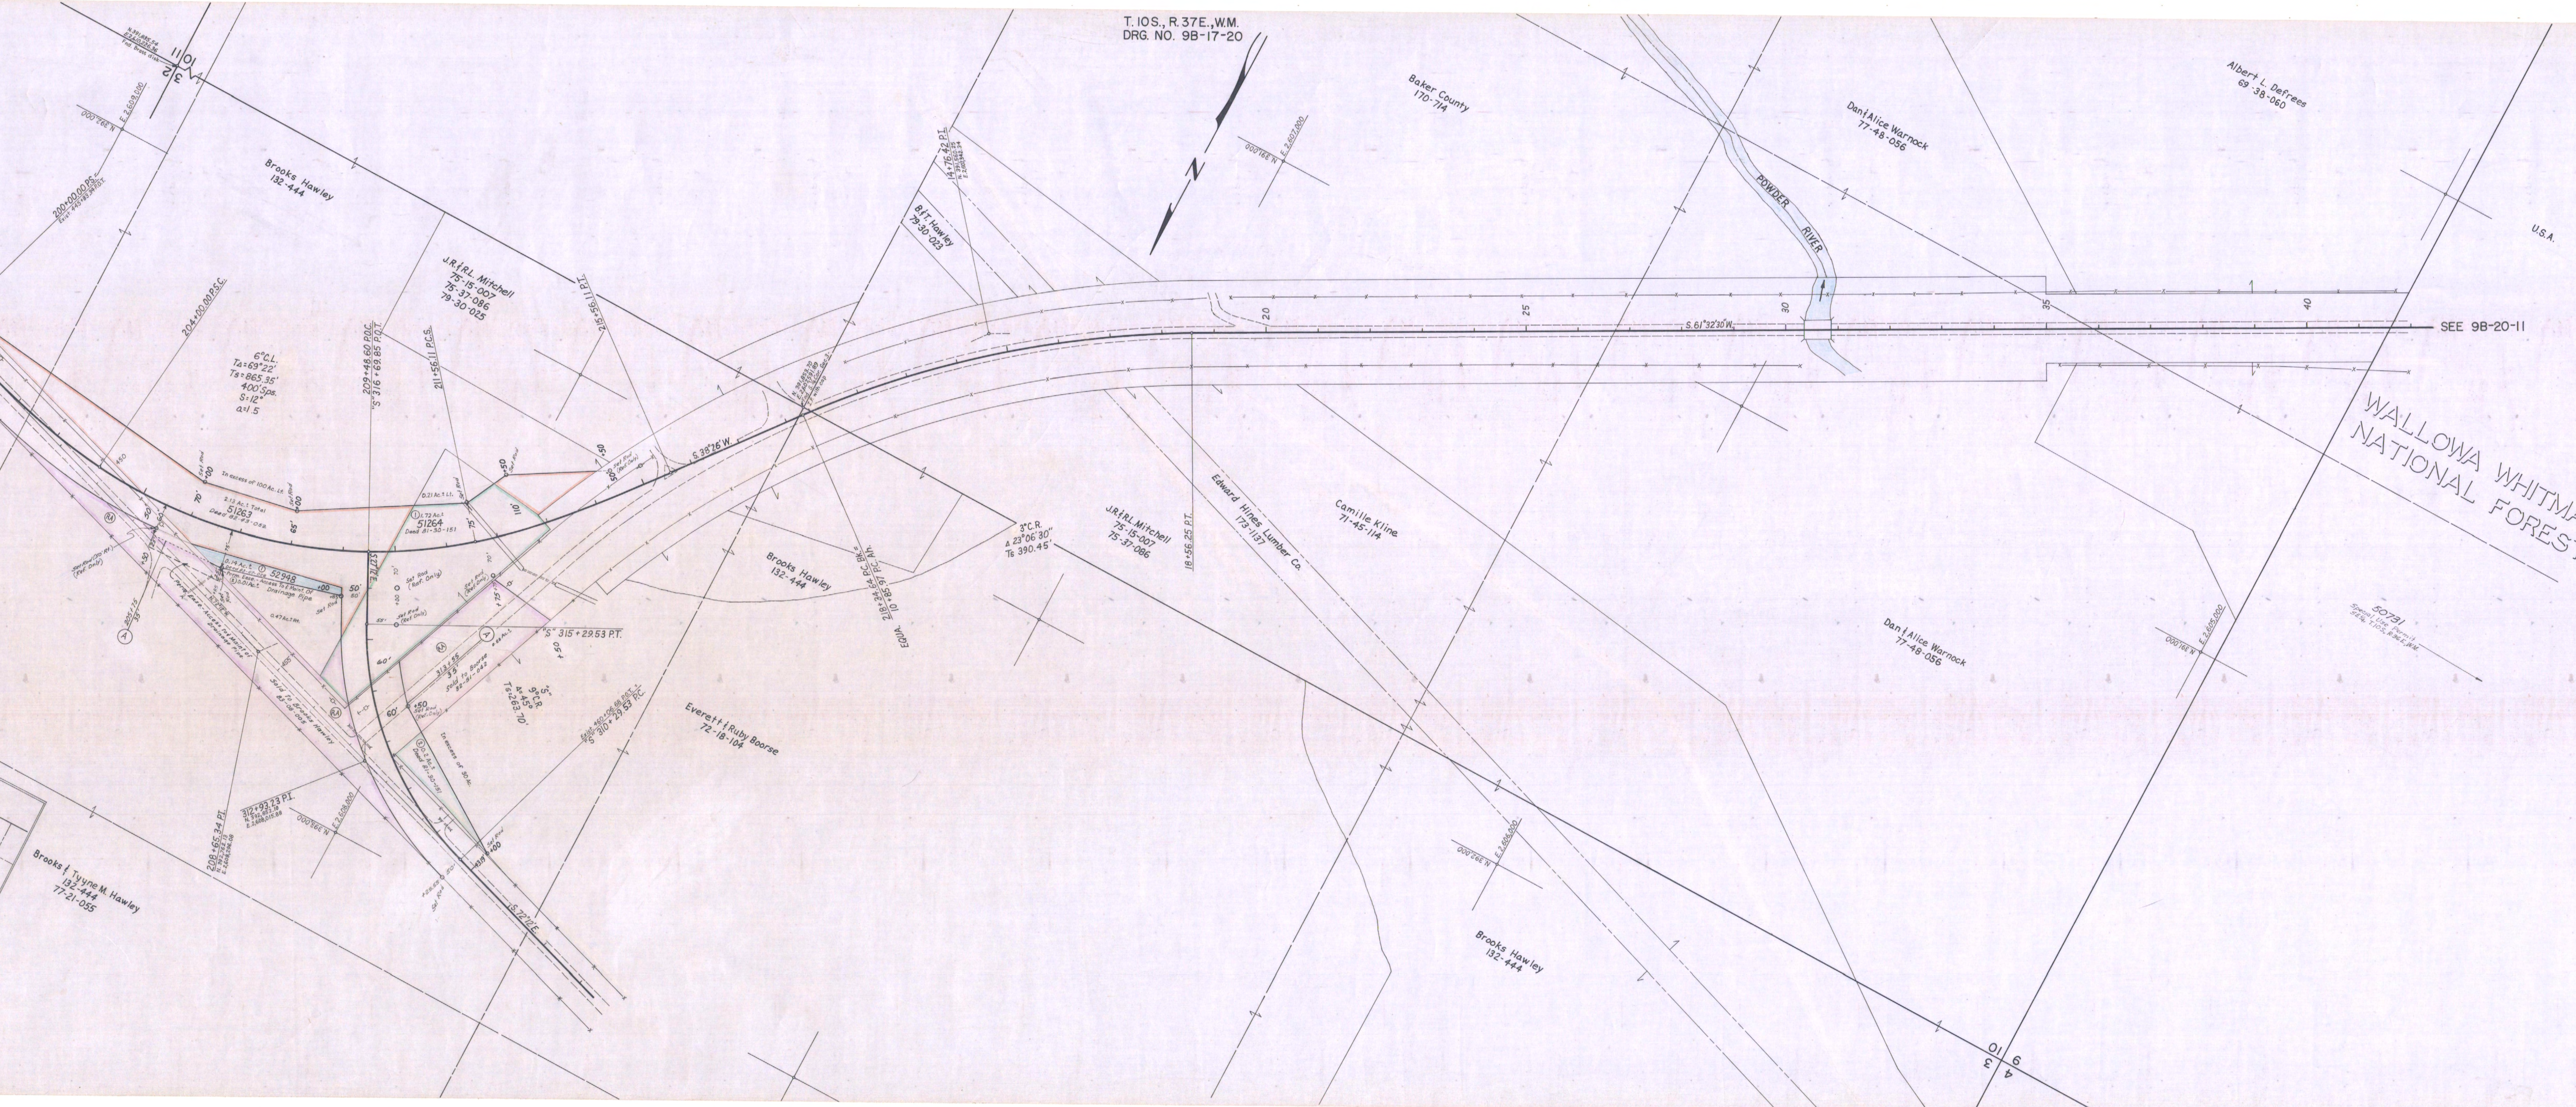

POWDER RIVER SECTION
WHITNEY HIGHWAY
BAKER COUNTY
SCALE: 1" = 100'
DRG. NO. 9B-17-20