


OREGON STATE HIGHWAY DEPARTMENT
Right-of-Way Map
BAKER UNDERXING SECTION
BAKER-UNITY HIGHWAY
BAKER COUNTY
Scale: 1"=100' Oct., 1941
Rev. Mar., 1981
JUN., 2002 S.C.C.
DRG. No. 6B-2-21

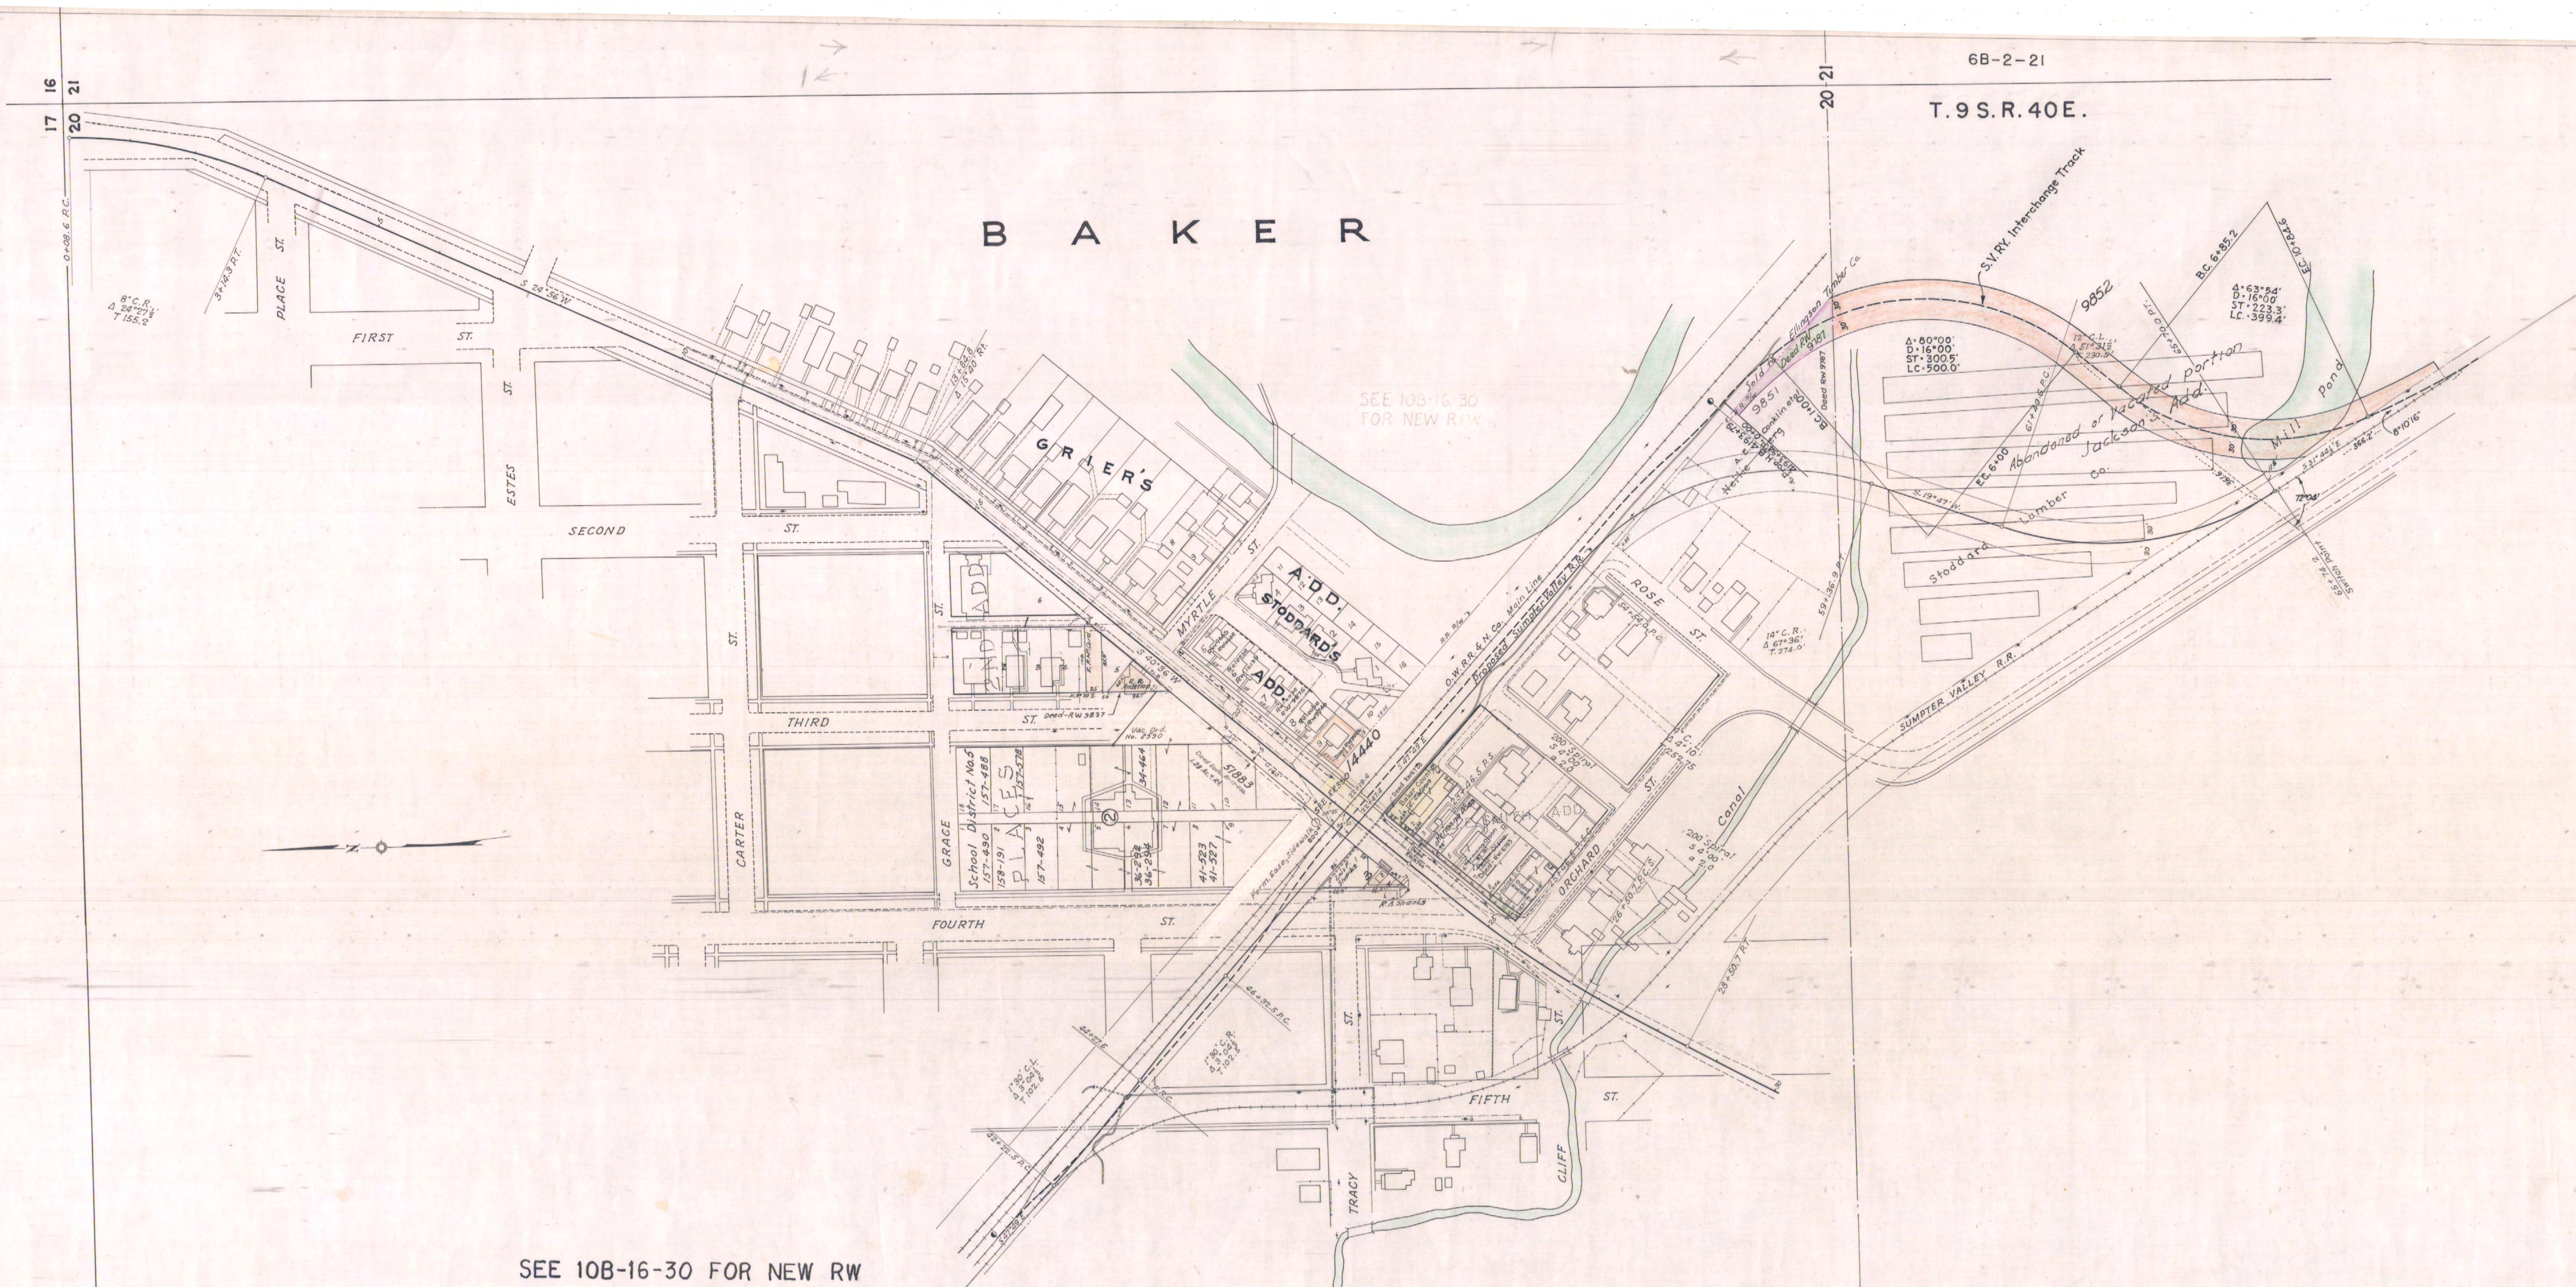

BAKER UNDERXING SECTION
DRG. No. 6B-2-21