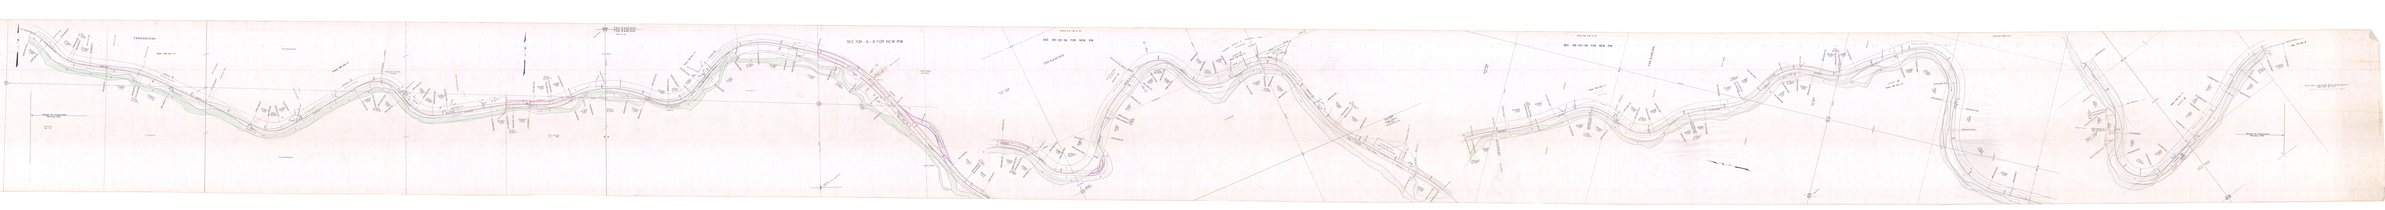

OREGON STATE HIGHWAY DEPARTMENT

Located Line

EAST UNIT OF LOVE BRIDGE - BLACK BRIDGE SECTION

BAKER-COPPERFIELD HWY.

~~BAKER-HOMESTEAD HIGHWAY~~

BAKER COUNTY

Scale : 1 inch = 100 feet

Traced by W.A.B. November, 1950

Revised: June, 1984

DRG. NO. 7B-4-10

See DRG. NO. 6B-16-10
T.9S.R.44E.W.M.
See 7B-20-17
U.S. Government
T.8S. R.44E.W.M.
T.9S. R.44E.W.M.
7B-4-10
U.S. Gov't
Revised As Constructed
February, 1955
S.H. Cooms
SEE 10B-6-8 FOR NEW RW
Grant T. Shold
DRG. No. 7B-4-10
SEE 9B-25-26 FOR NEW RW.
T.9S.R.44E.W.M.
Bridge No. 12-3
H.H. Jacobs
LOST CREEK
See 7B-20-17
20354 ⑥
EQUATION
Robert L. Young
Mining claim
Decision RW 14605
See 7B-34-8
East Unit Love Bridge-Black Bridge Section
DRG. NO. 7B-4-10
BAKER-COPPERFIELD HWY.
Revised As Constructed
February, 1955