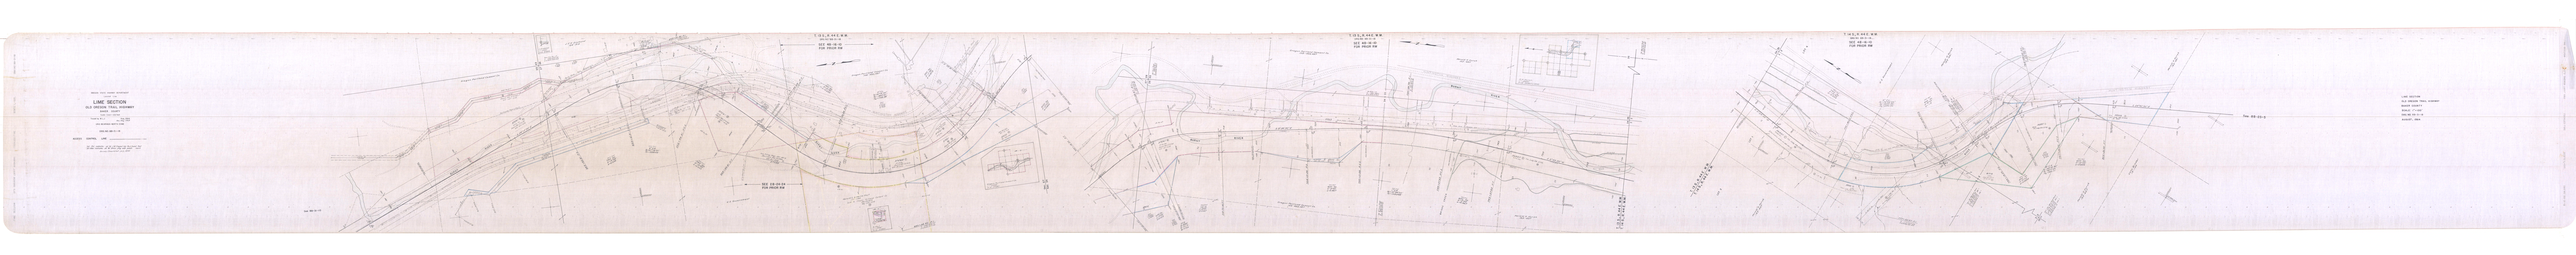

OREGON STATE HIGHWAY DEPARTMENT

Located Line

LIME SECTION

OLD OREGON TRAIL HIGHWAY

BAKER COUNTY

Scale: 1 inch = 100 feet

Traced by M.L.J. Aug., 1964
Rev. May, 1968

GRID BEARINGS-NORTH ZONE

DRG. NO. 8B-31-18

ACCESS CONTROL LINE ——————-——————-—

'Set Pin' indicates set 5/8" x 30" Capped Iron Pin & Guard Post
'Set Mon' indicates set 3/4" Brass plug with punch mark

Survey Completed July, 1970

T. 13 S., R. 44 E. W.M.
DRG. NO. 8B-31-18
SEE 4B-16-10
FOR PRIOR RW
J. & N. Diamond
164-513
Oregon Portland Cement Co.
Oregon Portland Cement Co.
108-483,487
HUNTINGTON HIGHWAY
BURNT RIVER
SEE 2B-24-24
FOR PRIOR RW
U.S. Government
Harold L. & Nellie Hoyt
Oregon Portland Cement Co.
See 8B-31-10
T. 13 S., R. 44 E. W.M.
DRG. NO. 8B-31-18
SEE 4B-16-10
FOR PRIOR RW
Oregon Portland Cement Co.
108-483,487
Harold H. Hursh
163-437
BURNT
RIVER
BURNT
RIVER
S 5°34'30" E
Oregon Portland Cement Co.
108-483,487
BRIDGE CREEK
Harold H. Hursh
163-437
T. 13 S., R. 44 E. W.M.
T. 14 S., R. 44 E. W.M.
T. 13 S., R. 44 E. W.M.
T. 14 S., R. 44 E. W.M.
LOT 1
LOT 2
LOT 4
T. 14 S., R. 44 E. W.M.
DRG. NO. 8B-31-18
SEE 4B-16-10
FOR PRIOR RW
U.S. Government
Harold H. Hursh
163-437
HUNTINGTON HIGHWAY
BURNT
RIVER
Harold H. Hursh
163-437
Harold H. Hursh
Lela Binder
See 8B-25-5

LIME SECTION
OLD OREGON TRAIL HIGHWAY
BAKER COUNTY
SCALE: 1" = 100'
DRG. NO. 8B-31-18
AUGUST, 1964