
 
 


EDWARDS & CUMMINGS, LLC
156 SE 1st. AVE., SUITE 1
ONTARIO, OREGON, 97914


LEGEND

PROPERTY LINE	
ORIGINAL LOT LINES	
BUILDING LINE	
ADJACENT BUILDING	
WATER VALVE	
FIRE HYDRANT	
LUMEN POLE	
TRAFFIC SIGNAL POLE	
CATCH BASIN	
GAS METER	
POWER BOX OR METER	
SIGN AS NOTED	
MANHOLE	
TELEPHONE RISER	
WATER METER	
SET 5/8"Ø REBAR W/PLASTIC CAP L.S. 2316	
PARKING SPACE	
LIMITED COMMON ELEMENT	
GENERAL COMMON ELEMENT	
NONWITHDRAWABLE VARIABLE PROPERTY	

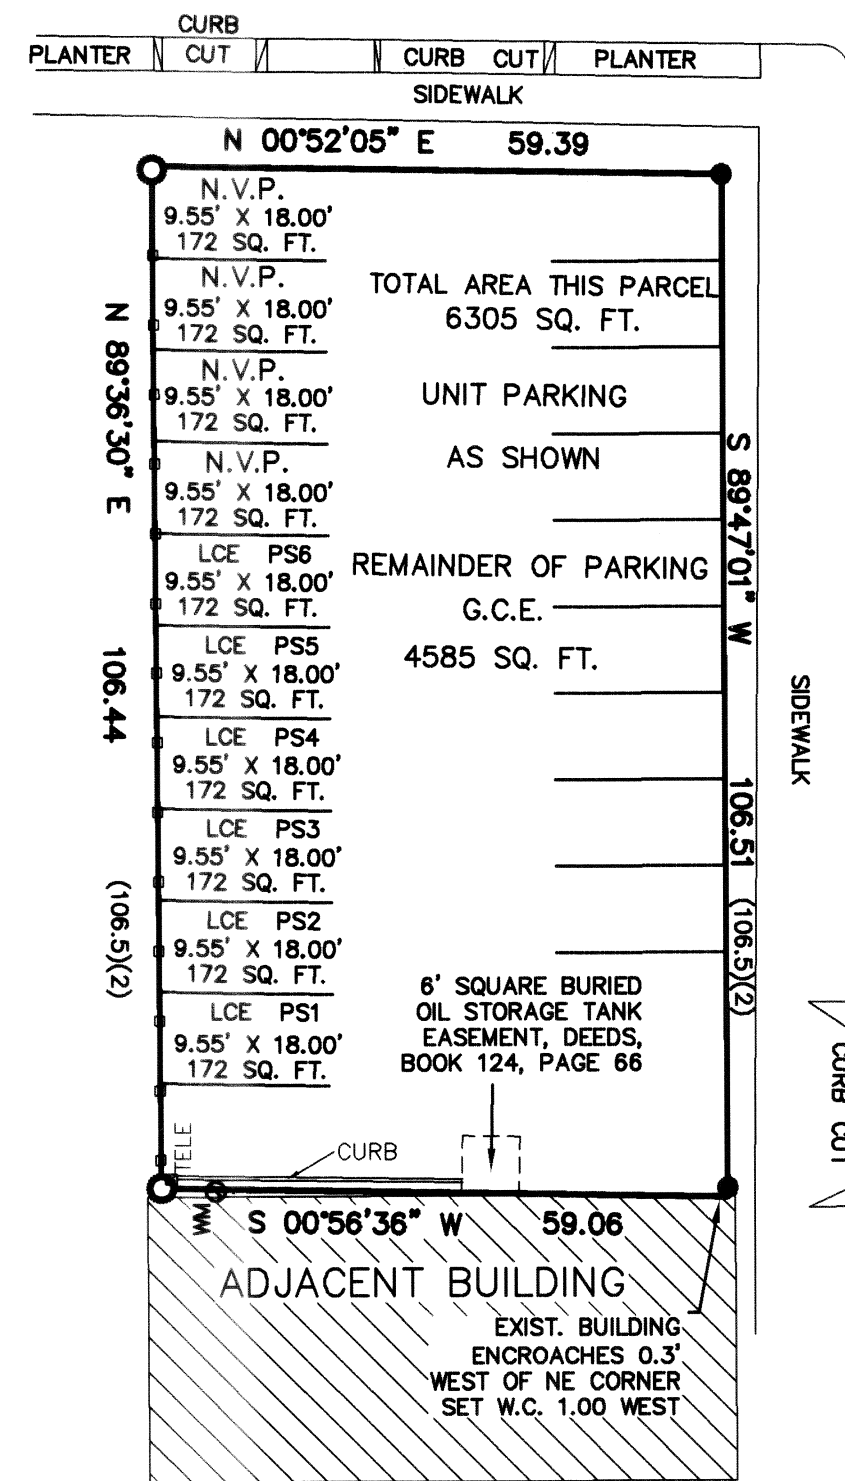


NOTE: PARKING SPACES ARE LIMITED
COMMON ELEMENTS, AND ARE
ASSIGNED IN THE DECLARATION.


— SEE
DETAIL 1

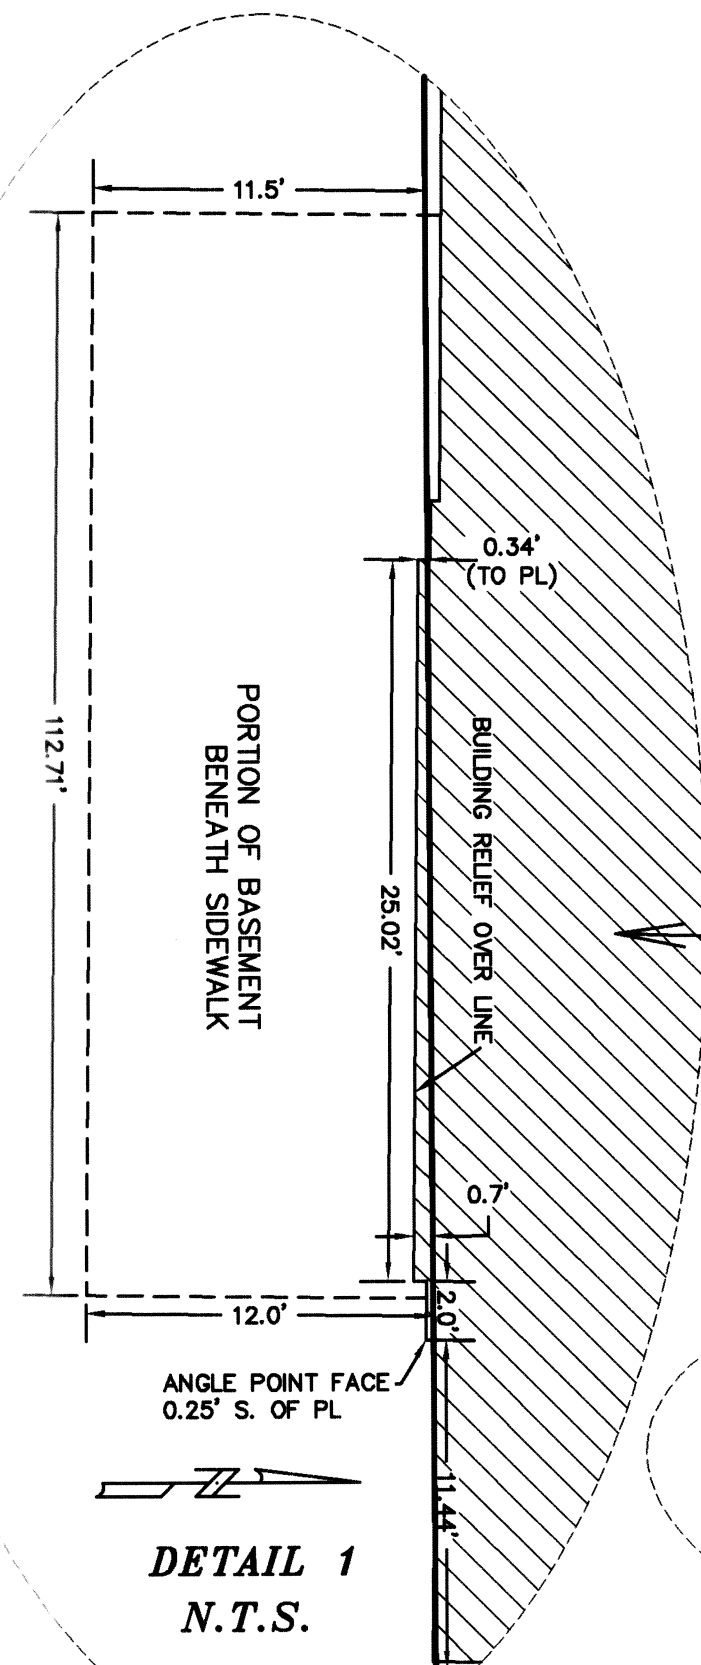

DETAIL 2
N.T.S.

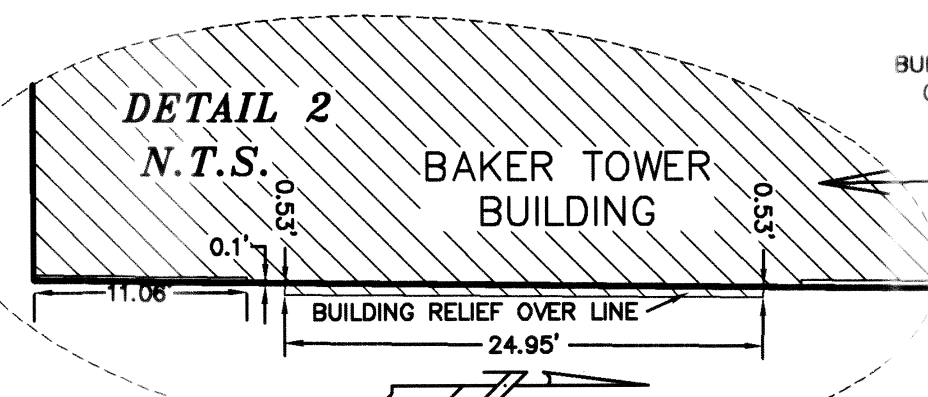BARKER TOWER
BUILDING

**SEE
DETAIL 2**

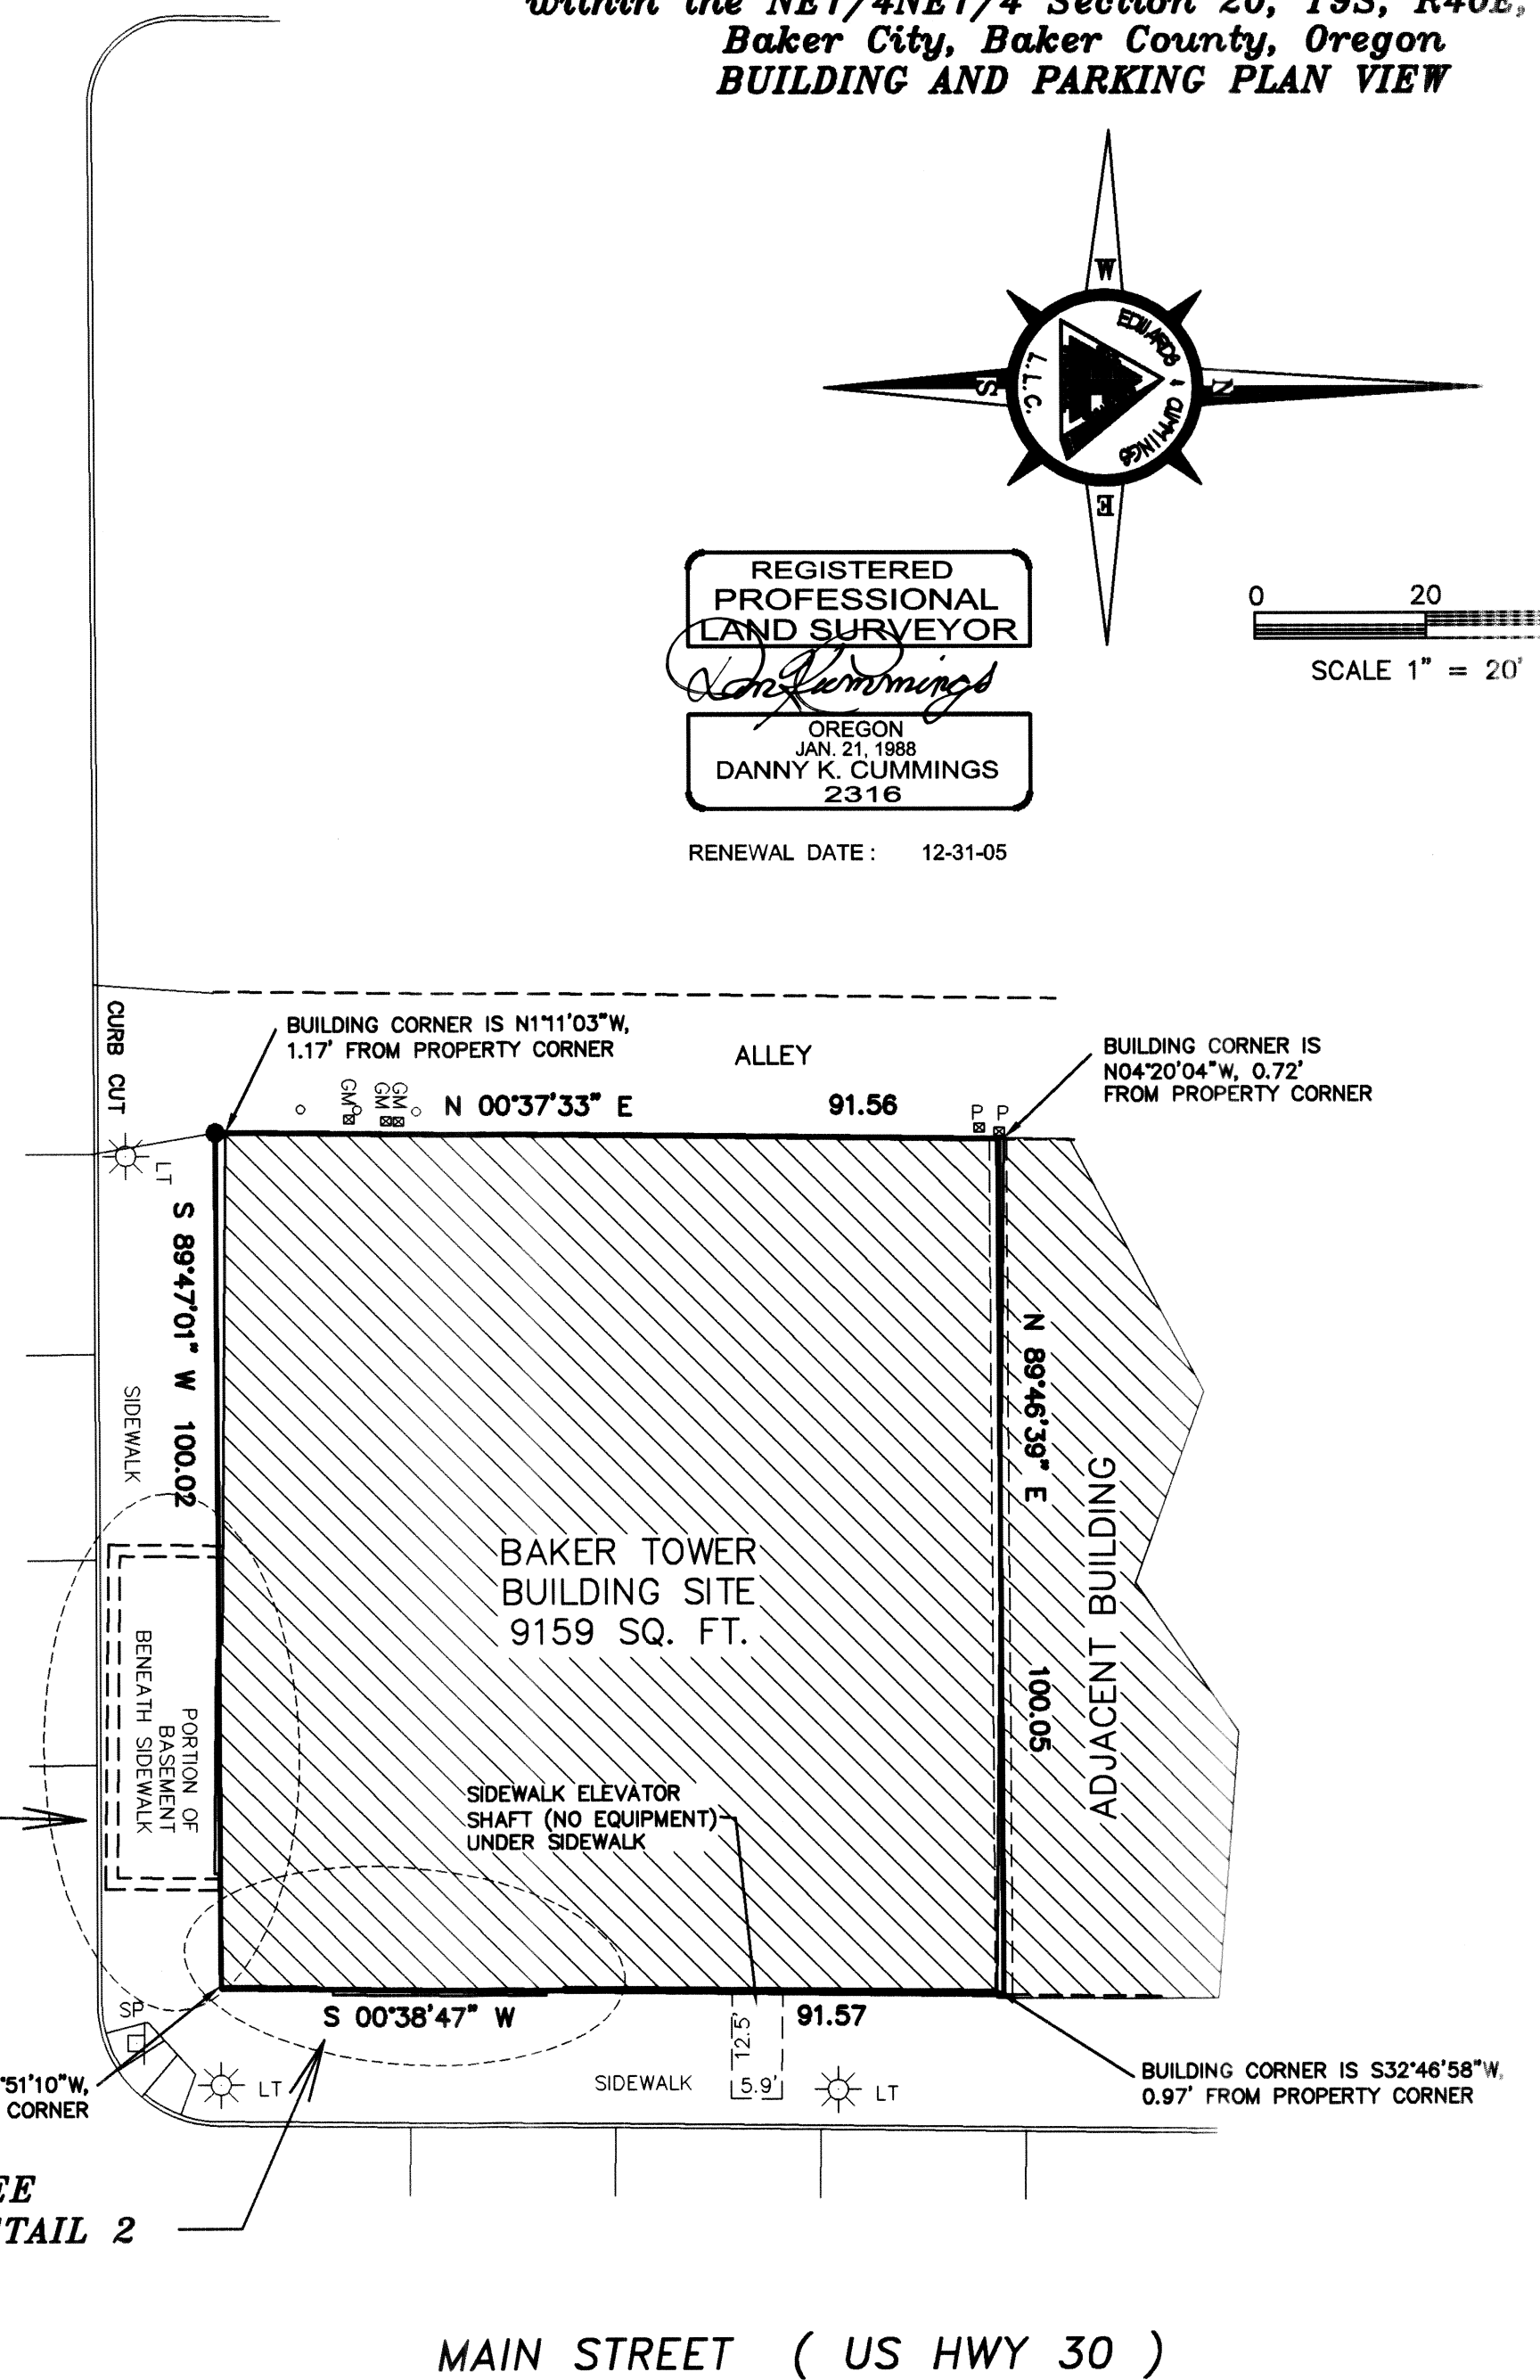

MAIN STREET (US HWY 30)