

POLLMAN BUILDING CONDOMINIUMS


Ceiling of Units 201, 202 & 203 - ELEV. = 3467.1'	
SECOND FLOOR	
Floor of Units 201, 202 & 203 - ELEV. = 3455.1'	
Ceiling of Unit 101 - ELEV. = 3453.5'	
Ceiling of Unit 102 - ELEV. = 3452.6'	
Ceiling (false ceiling) of Unit 101 - ELEV. = 3449.4'	
FIRST FLOOR	
Main floor of Unit 101 & Unit 102 - ELEV. = 3438.9'	
Ceiling of Unit 102 (Basement) - ELEV. = 3438.0'	
Ceiling of Unit 101 (Basement) - ELEV. = 3437.6'	
BASEMENT	
Floor of Unit 102 (Basement) - ELEV. = 3431.6'	
Floor of Unit 101 (Basement) - ELEV. = 3429.6'	

NOT TO SCALE

NOTE: FLOOR ELEV. OF UNIT 102 (BASEMENT)
VARIES BY APPROXIMATELY ±0.3'.

VERTICAL DATUM


Vertical datum based upon the U.S.G.S. Brass Cap Monument stamped "J2 1933", set vertically in the North wall of the subject building. Monument is approximately 12' East of the Northwest building corner and 4.5' above the sidewalk. Elevation = 3443.05' (NGVD '29).

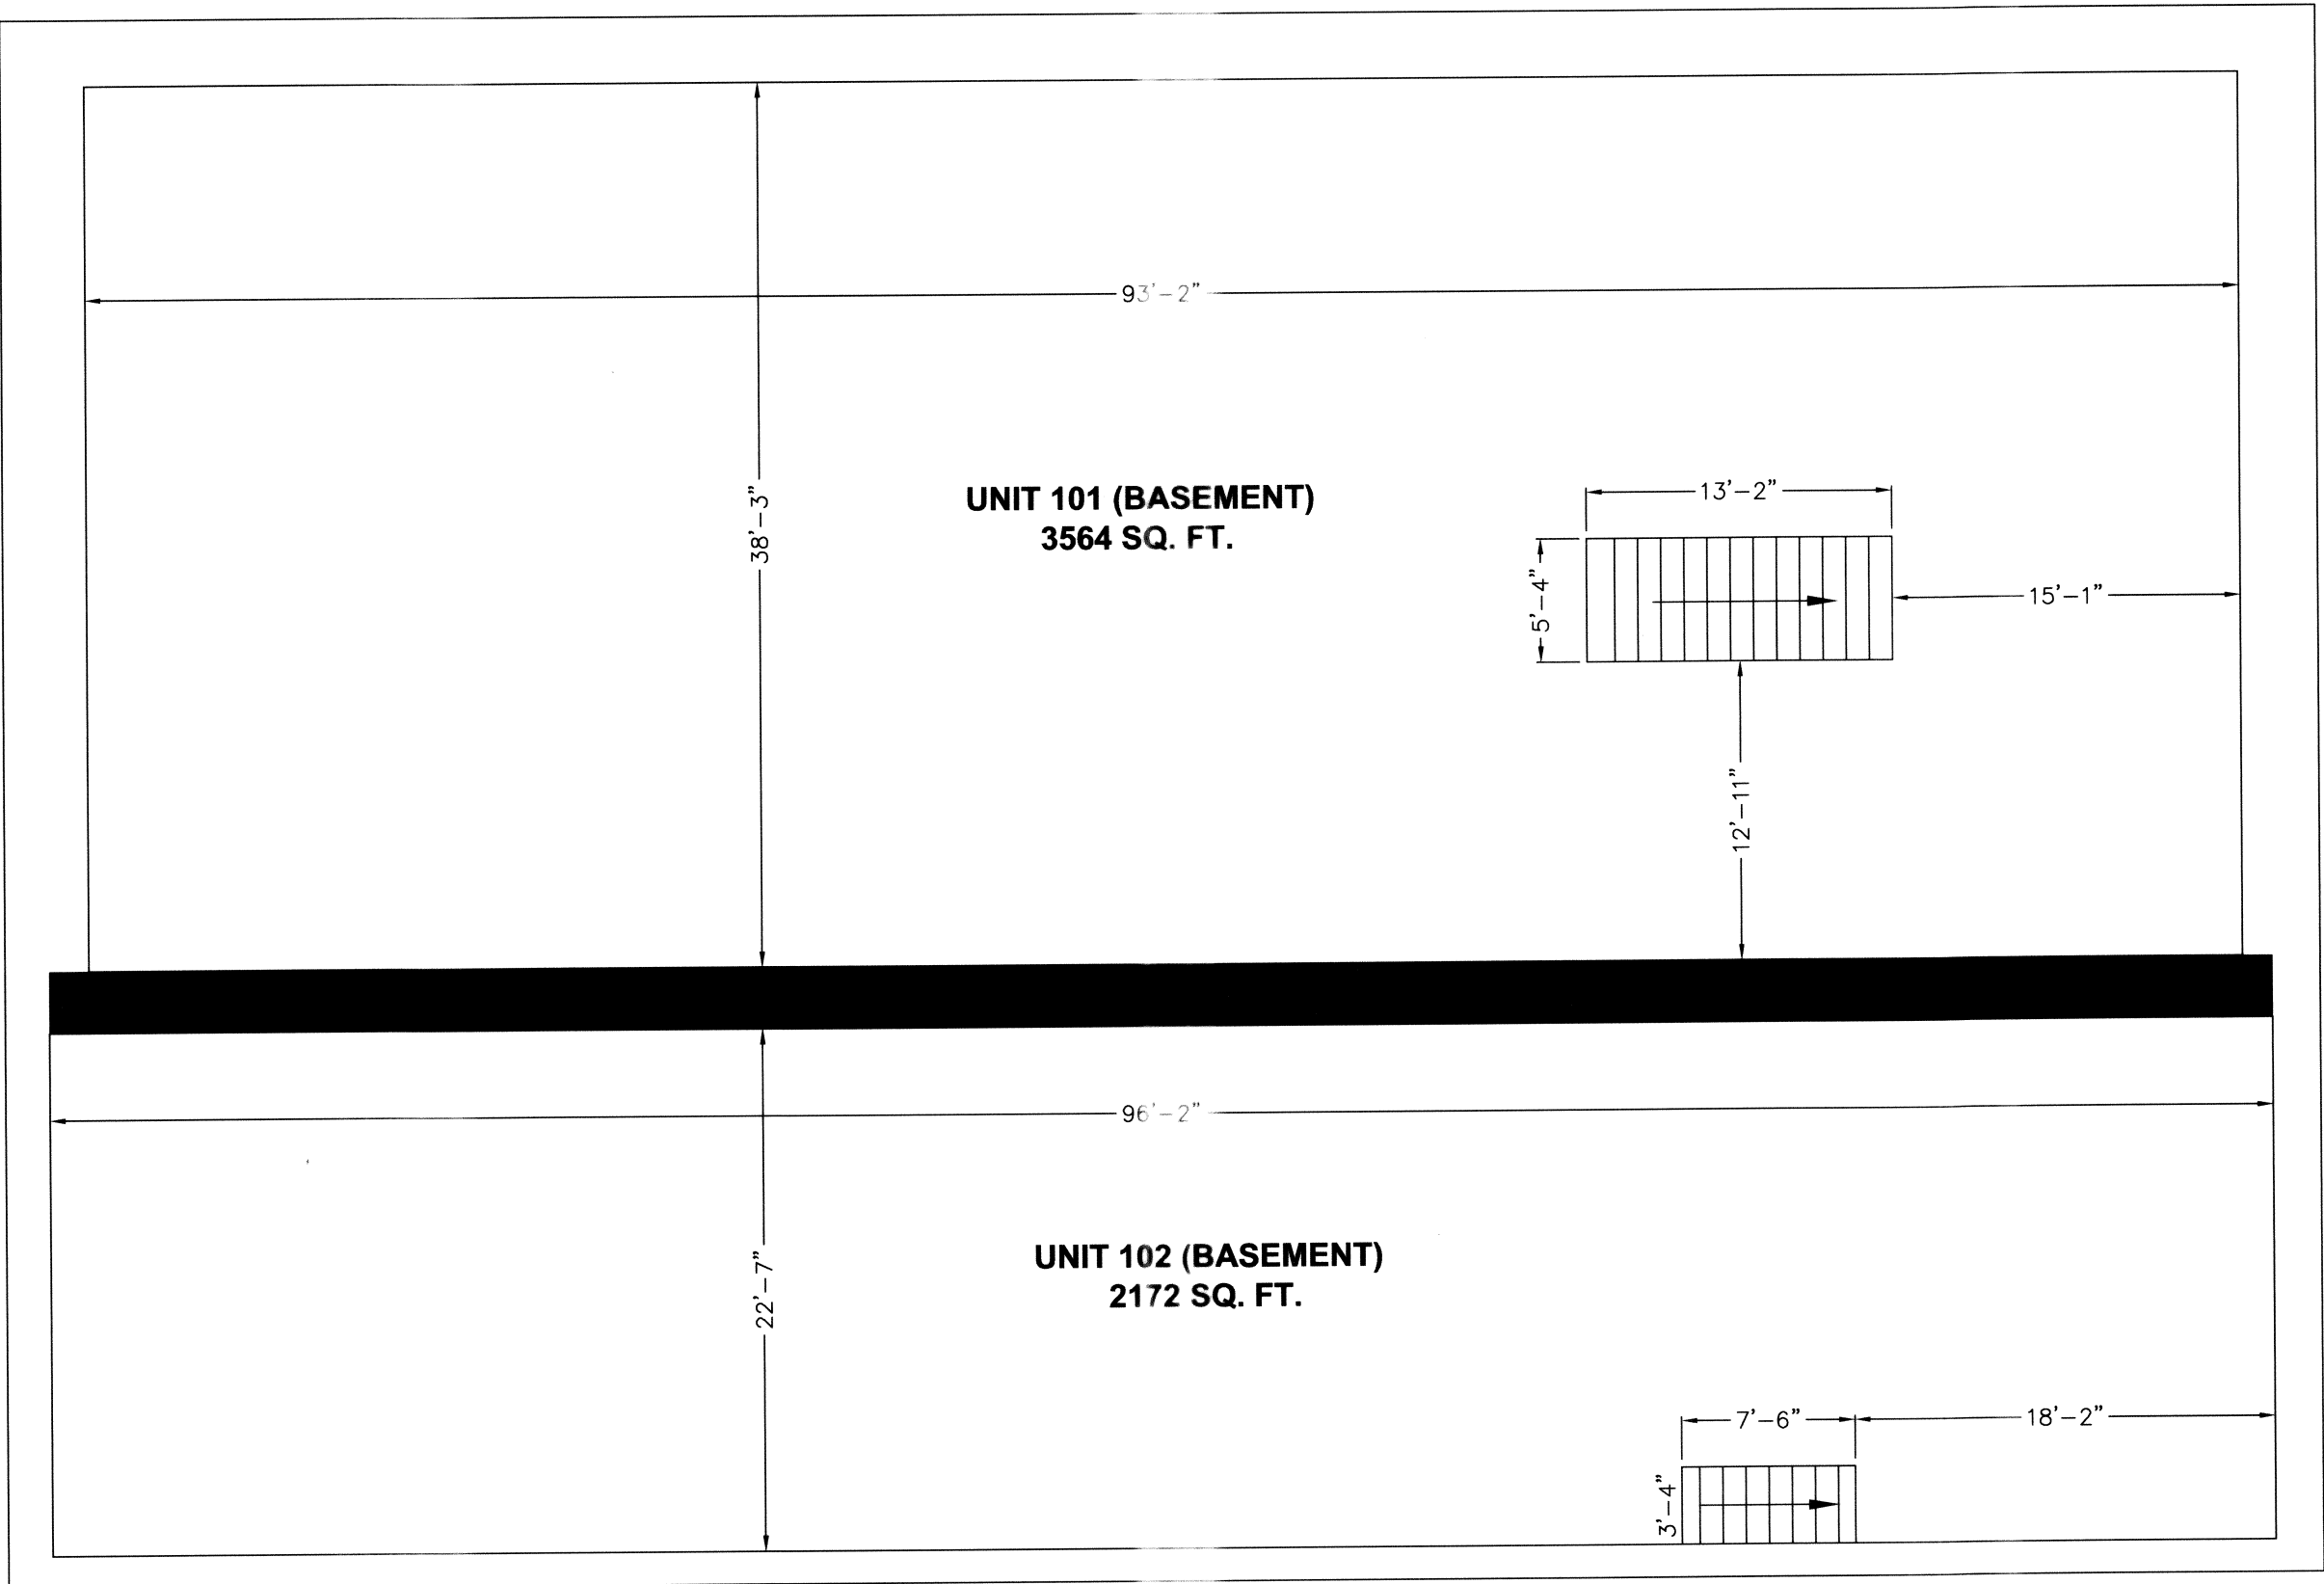

LEGEND

- Interior Unit Boundary
- L.C.E. Limited Common Element

UNITS 101 (BASEMENT) AND 102 (BASEMENT)

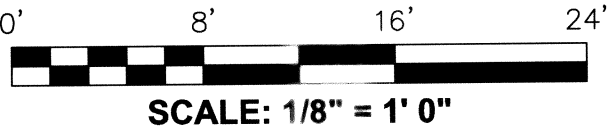

SCALE: 1/8" = 1' 0"

HANLEY ENGINEERING, INC.

P.O. BOX 701, 2043 MAIN STREET, BAKER CITY, OREGON 97814 (541) 523-3803

**REGISTERED
PROFESSIONAL
LAND SURVEYOR**

Thomas J. Hanley

OREGON
JULY 13, 1979
THOMAS J. HANLEY
1817

Renews June 30, 2005