



This Map is
an original

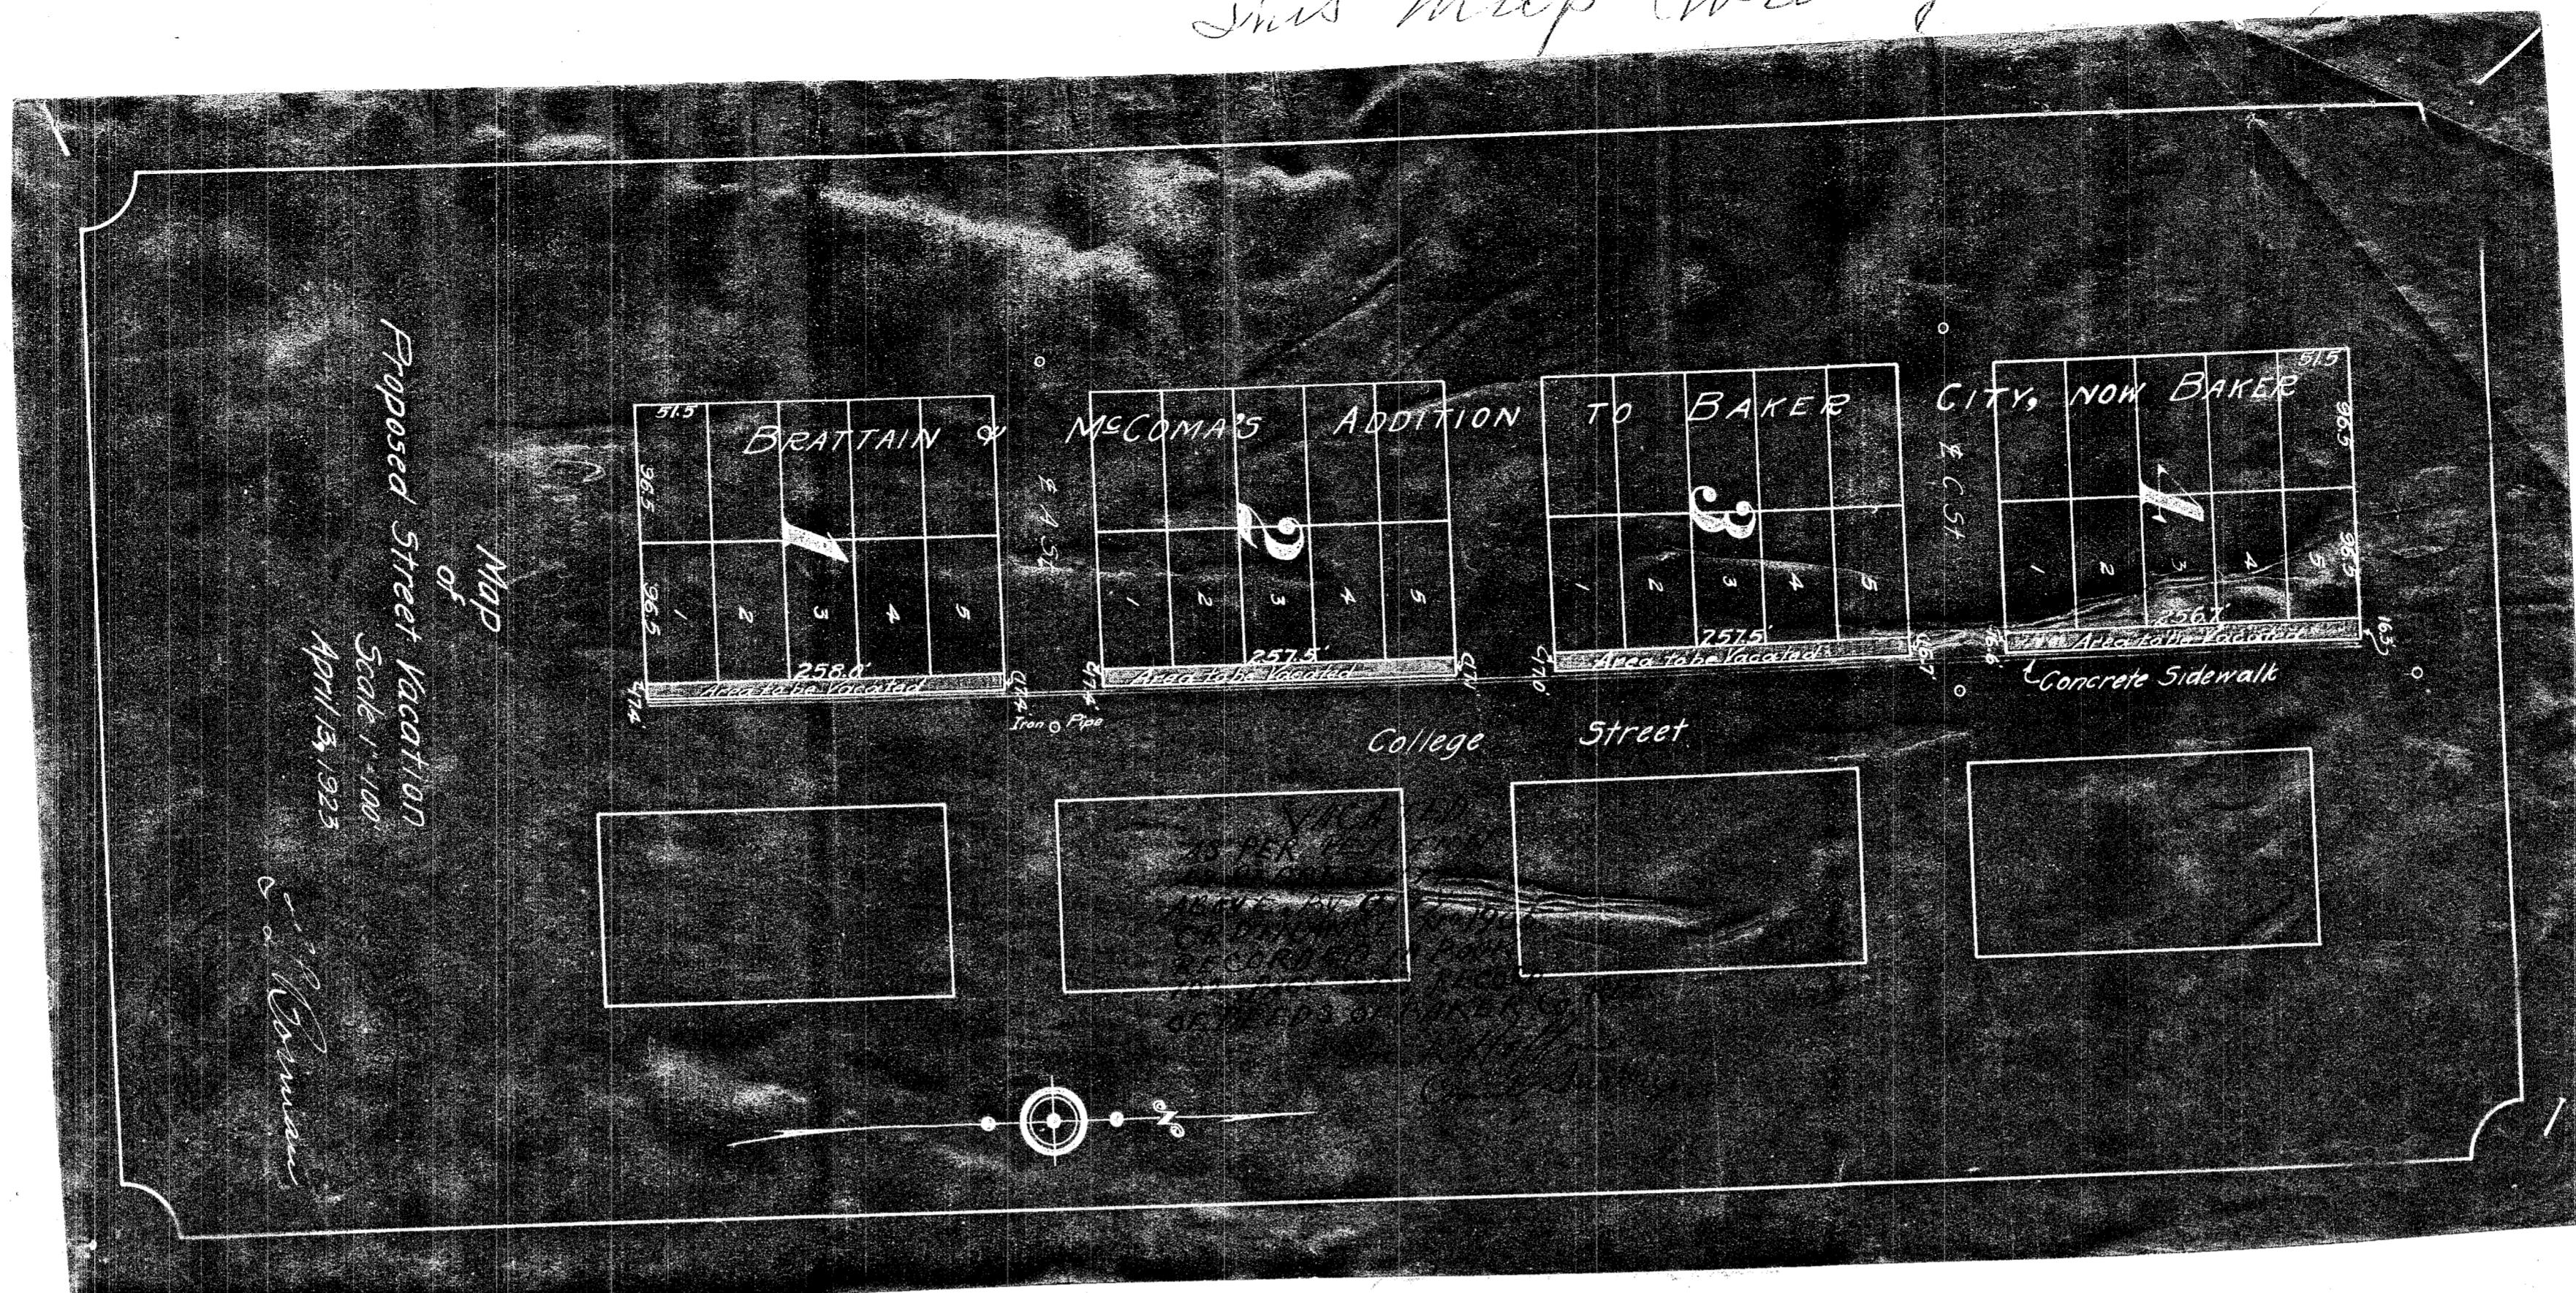

Plan
of
John Brattain & F.S. McComas'
Addition
to
Baker City
Situate in
the SW 1/4 of the NE 1/4 of Section 35^{1/2} T 1 N
in Township 35^{1/2} S of Range 3 E
East in Baker County Oregon

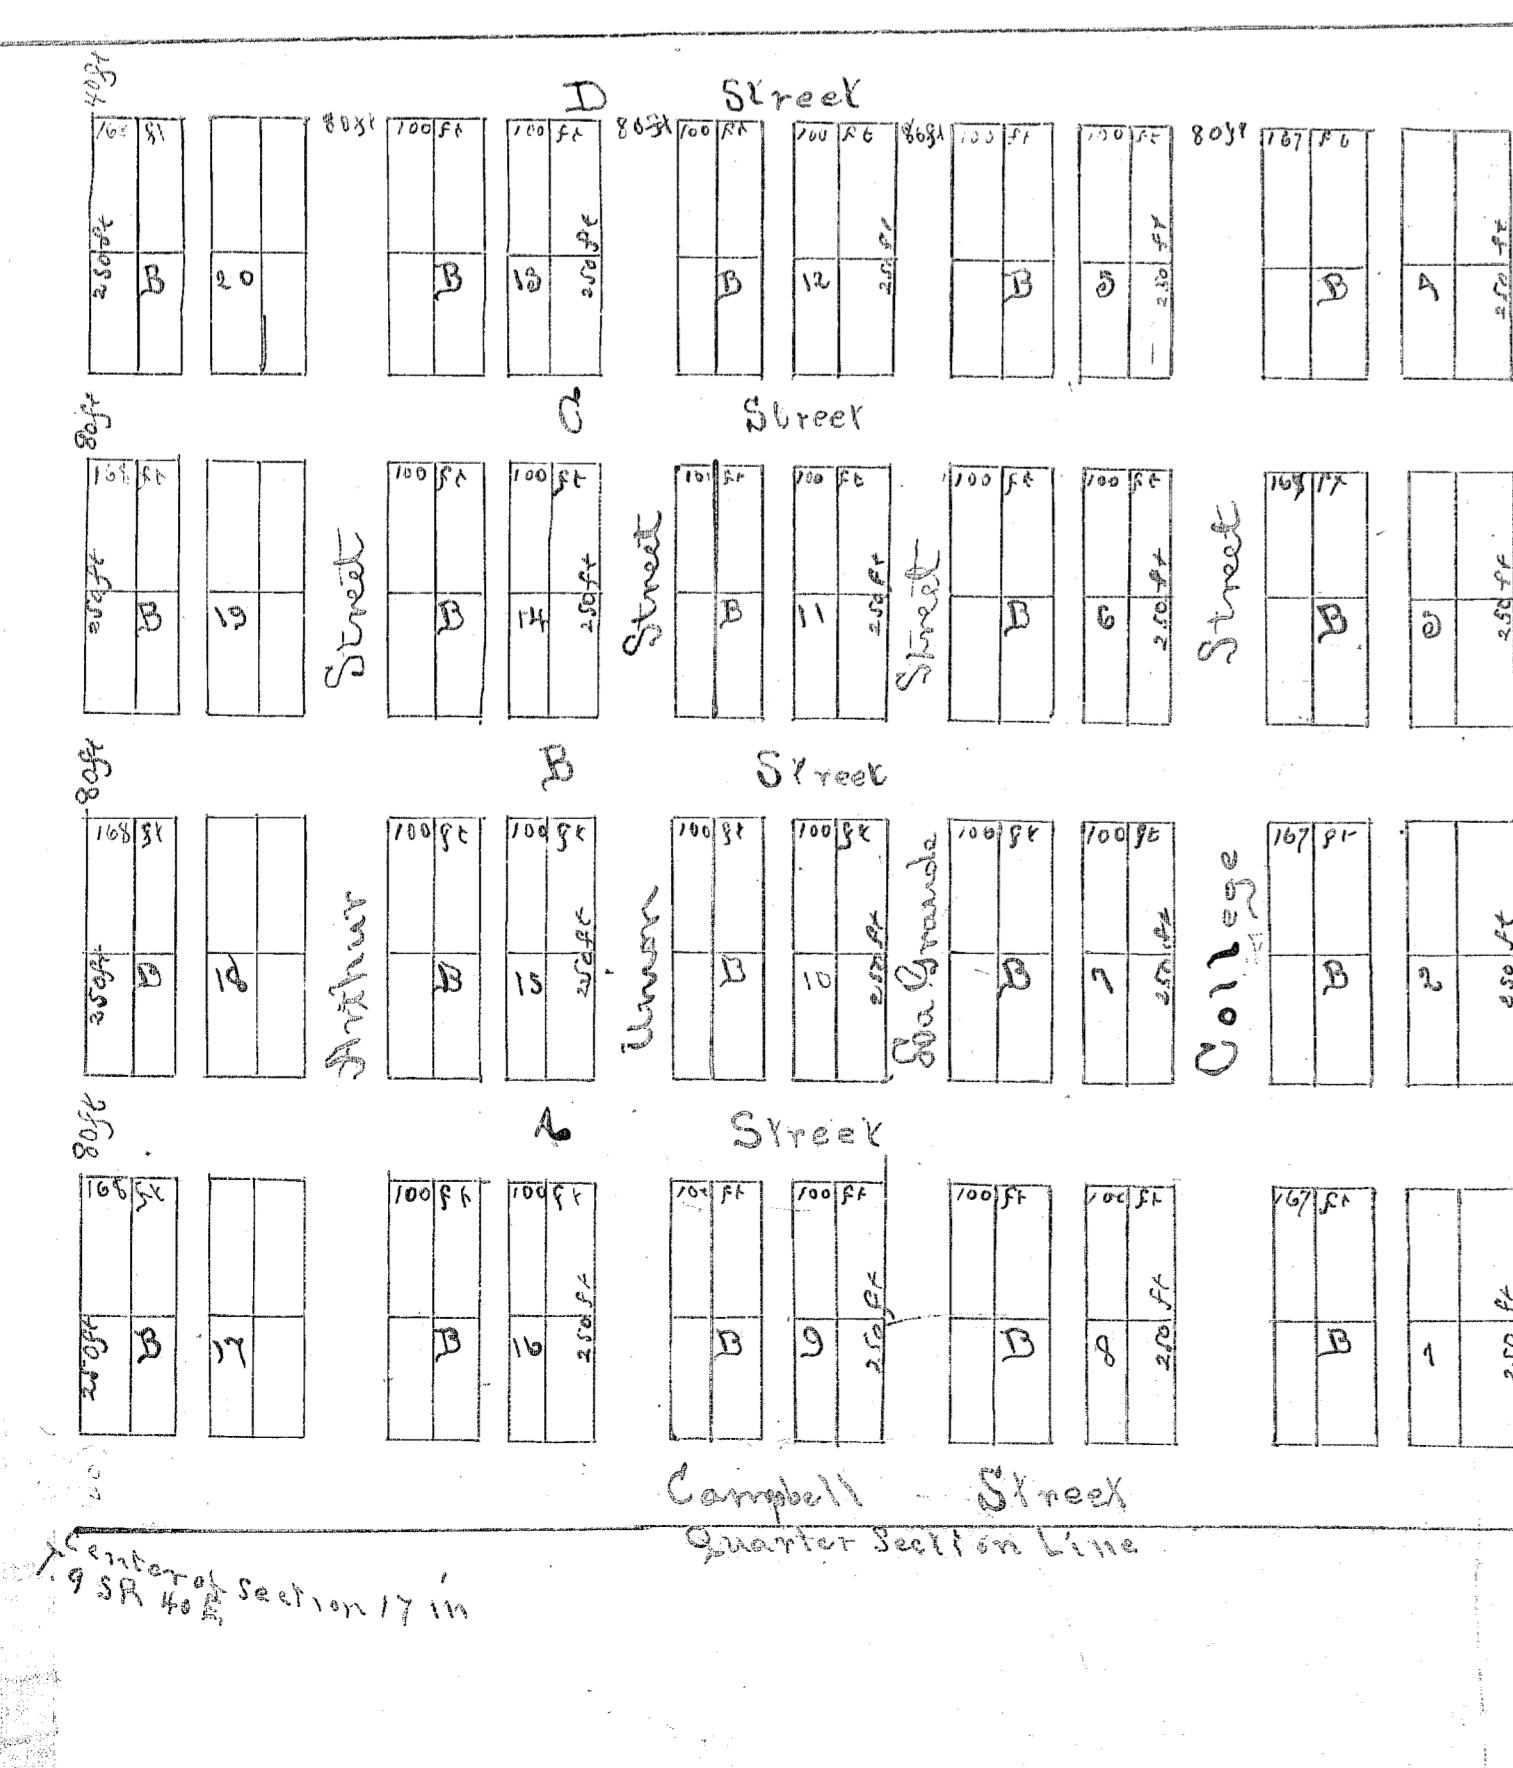

State of Oregon
County of Baker }
Before the undersigned, a Notary Public in and for the
County and State aforesaid, duly commissioned, sworn personally appeared,
John Brattain of the firm of Brattain & McComas personally known to me to be the
identical person. And he said John Brattain acknowledged to me that he
who laid out, surveyed, platted and recorded the land, represented by this plat
and designated hereon as Brattain & McComas' addition to Baker City as
a Townsite; that the dimensions of the lots and blocks are represented
on this plat and are to be used for the purpose of business, trade and
commerce.

Witness my hand and seal of Office this day
of April 1882

Dewitt W. Reynolds
Notary Public
Baker Co., Oregon

Filed for Record April 26th 1882 at 9 o'clock A.M.

T. D. Parker

County Clerk.