



# Cornucopia

Union County, Oregon.

For "Original" See  
Volume 57 Page 220

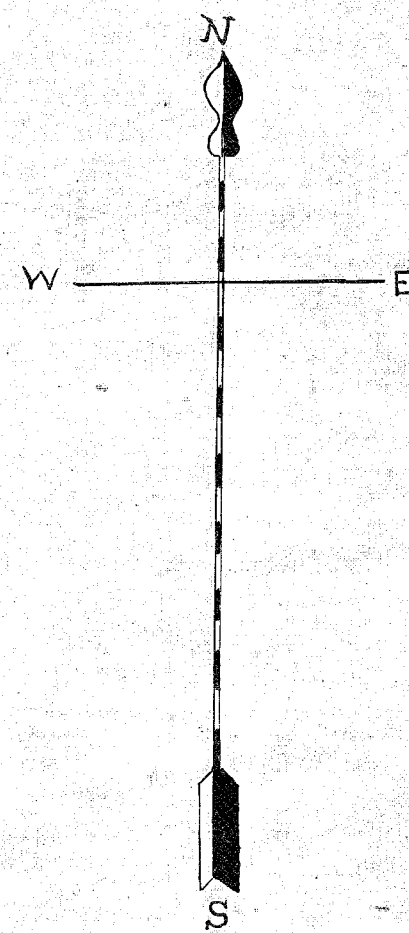

This to Correct  
Original Plot  
in 1-718

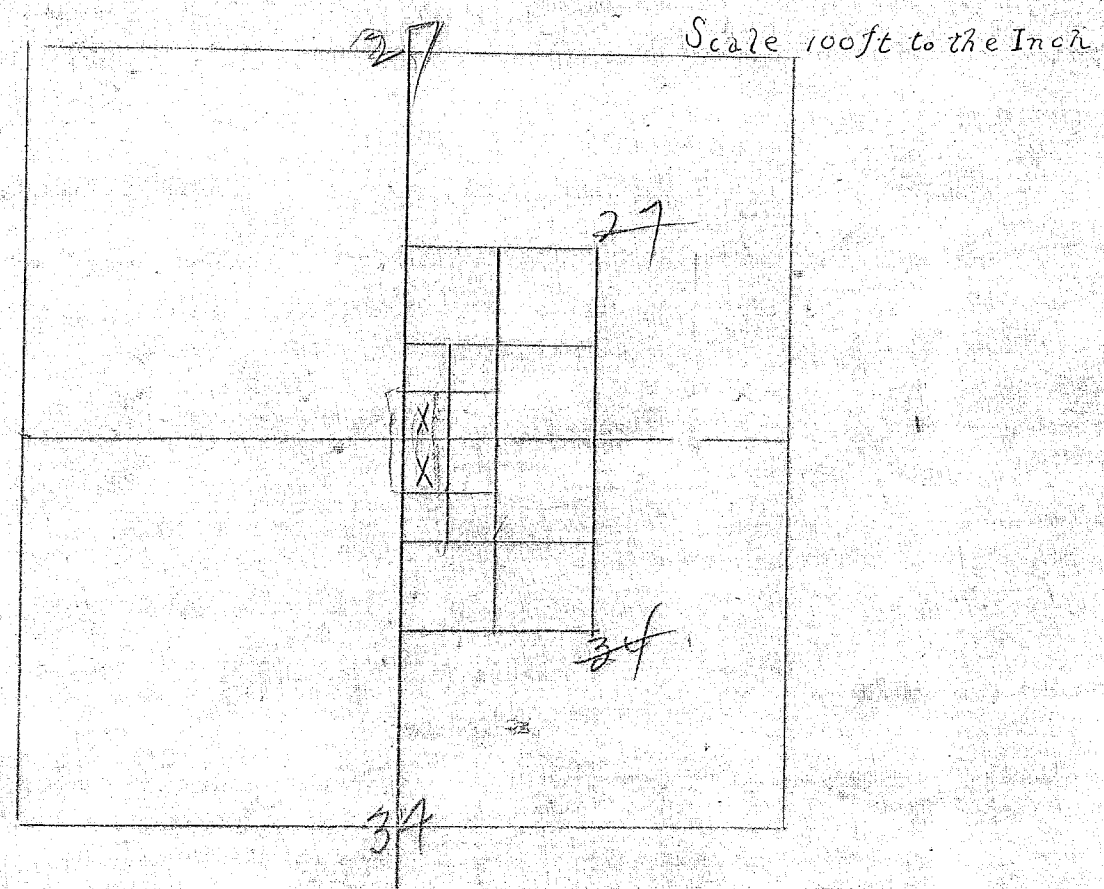

9 8 10 7 11 6 12 19 5 13 4 14 3 15 2 16 1	9 8 10 7 11 6 12 18 5 13 4 14 3 15 2 16 1	60' 9 8 10 7 11 6 12 7 5 13 4 14 3 15 2 16 1	9 8 10 7 11 6 12 6 5 13 4 14 3 15 2 16 1
5	FIR	STREET	
9 8 10 7 11 6 12 20 5 13 4 14 3 15 2 16 1	9 8 10 7 11 6 12 17 5 13 4 14 3 15 2 16 1	9 8 10 7 11 6 12 8 5 13 4 14 3 15 2 16 1	9 8 10 7 11 6 12 5 5 13 4 14 3 15 2 16 1
5	GREEN	STREET	
9 8 10 7 11 6 12 21 5 13 4 14 3 15 2 16 1	STREET 9 8 10 7 11 6 12 16 5 13 4 14 3 15 2 16 1	STREET 7 6 8 5 9 4 10 9 3 11 2 12 1 A B C	STREET 9 8 10 7 11 6 12 7 5 13 4 14 3 15 2 16 1
60'	FIRST 50' 9 8 10 7 11 6 12 22 5 13 4 14 3 15 2 16 1	STREET 9 8 10 7 11 6 12 15 5 13 4 14 3 15 2 16 1	50' F E D 9 8 10 7 11 6 12 10 5 13 4 14 3 15 2 16 1
50'	ALLEN	MAIN	CORY
9 8 10 7 11 6 12 23 5 13 4 14 3 15 2 16 1	50' 9 8 10 7 11 6 12 14 5 13 4 14 3 15 2 16 1	STREET 9 8 10 7 11 6 12 11 5 13 4 14 3 15 2 16 1	9 8 10 7 11 6 12 2 5 13 4 14 3 15 2 16 1
50'	SECOND	STREET	
9 8 10 7 11 6 12 24 5 13 4 14 3 15 2 16 1	50' 9 8 10 7 11 6 12 13 5 13 4 14 3 15 2 16 1	9 8 10 7 11 6 12 12 5 13 4 14 3 15 2 16 1	9 8 10 7 11 6 12 1 5 13 4 14 3 15 2 16 1
50'	THIRD	STREET	
