


and from 1886 to 1886.
 J. R. Wisdom
 County Clerk

and added page 260 and 261
 to the Records of Deeds
 Baker County, Oregon

LININGTON ADDITION

Situated in Section 20 T. 9. S. R. 7. E. in Baker County State of Oregon.

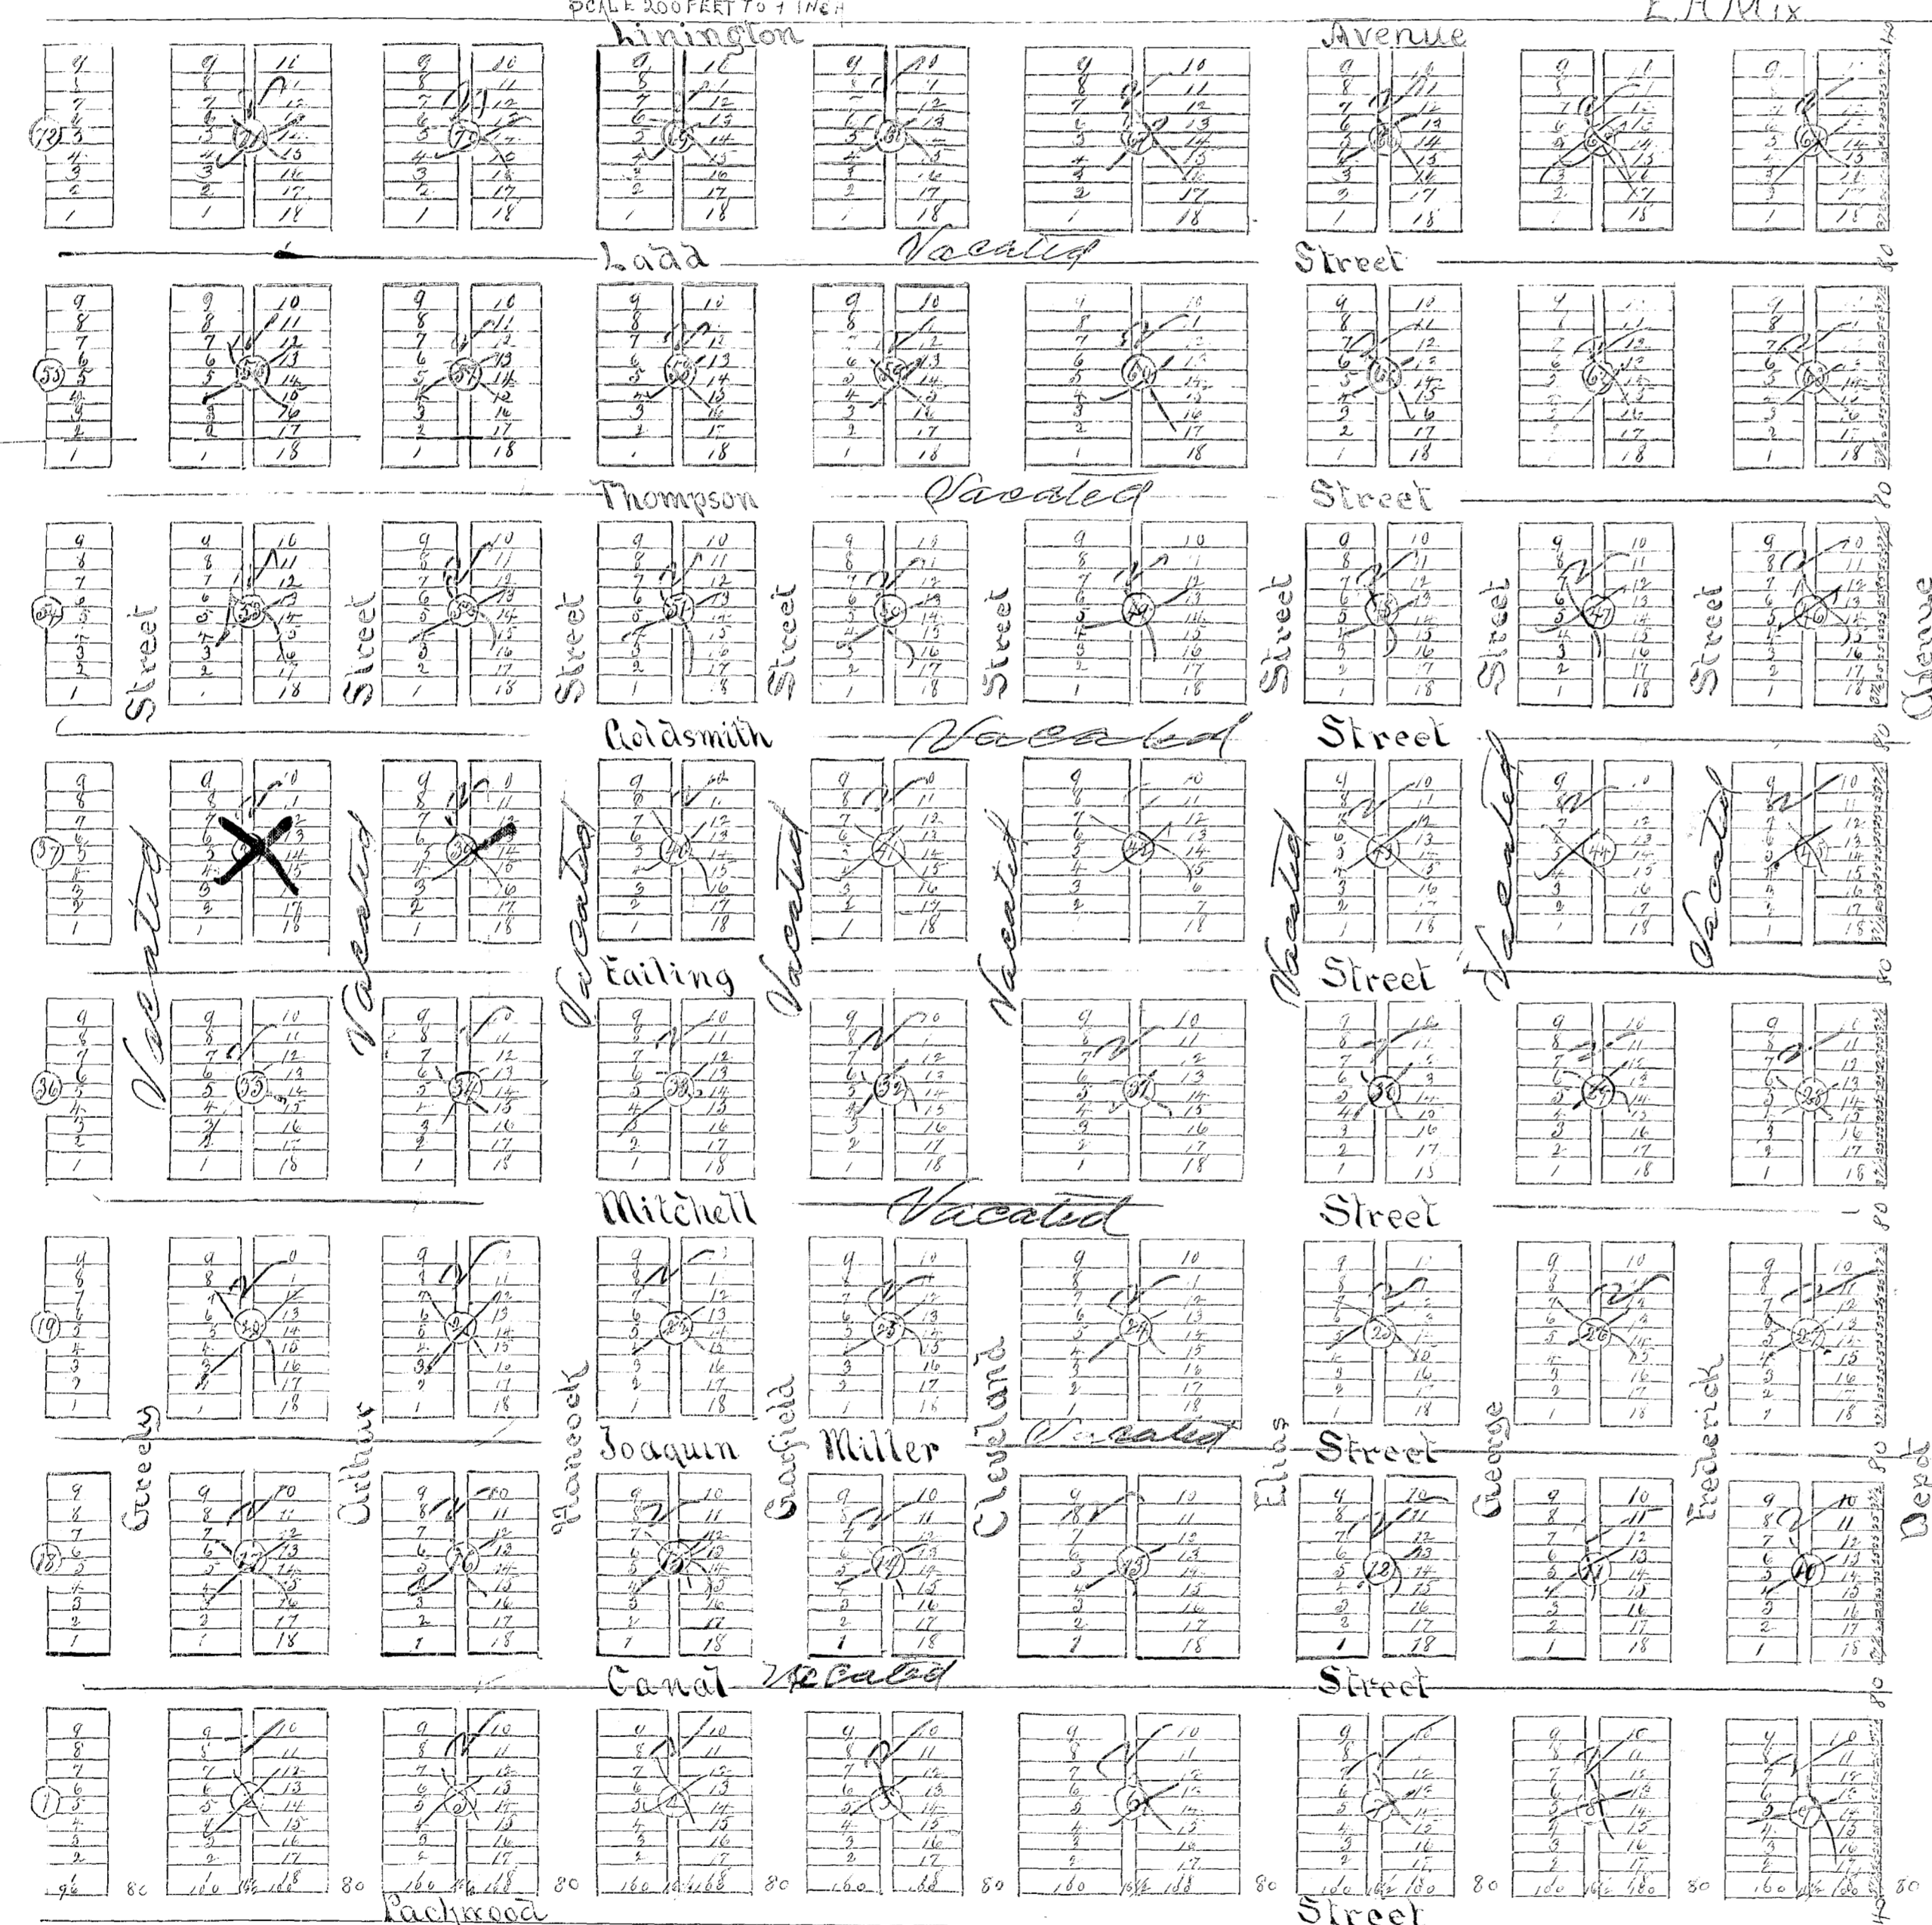

I hereby certify that I have read the Ordinance
 No. 2125 passed by the City Commissioners of the
 City of Baker and recorded in Book 123 of Deeds
 at page 338 thereof and that I have marked as
 Vacated all the Streets & Blocks in the Linington
 Addition as shown in said Ordinance.
 I notice that some of the Streets have been given
 a different name and no notation was on
 this the original Plat.


Dated at Baker Oregon this
 18th day of March 1937

State of Illinois }
 County of Cook }

John R. Waller

This certifies that on this ninth 9th day of April A. D. 1886 personally appeared before the undersigned a commissioner for the State of Oregon, residing in
 Chicago, County of Cook, and State of Illinois, John R. Waller of Charles City, County of Floyd and State of Iowa to me personally known to be the identical person
 executed this map of the Linington Addition to Baker City, Situated in Section Twenty-two Township Nine (9) South Range Forty-two East, in Baker County, State of Ore
 and acknowledged to me that he executed the same freely for the uses and purposes therein set forth.

Witness: Samuel E. May
 C. E. McErmas

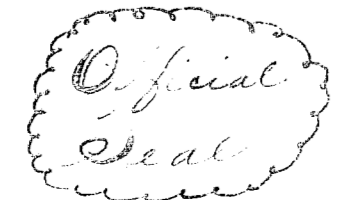

I testify whereof I have hereunto set my hand
 and seal, this ninth day first above written.

Samuel E. May
 Commissioner for Oregon