


Revised Plan
 of the
M^cCrary Addition to Baker City
 Situated on the W¹/₂ NE¹/₄ & E¹/₂ N.W¹/₄ of Section 20
 T¹/₂ S. R. 40 E. W. M. in Baker County, State of Oregon.
 Surveyed and Platted at request of
 M. D. Wisdom, L. J. Estes & R. D. Carter by E. H. Mix, October 1886.
 Scale 200 Ft. = 1 Inch.

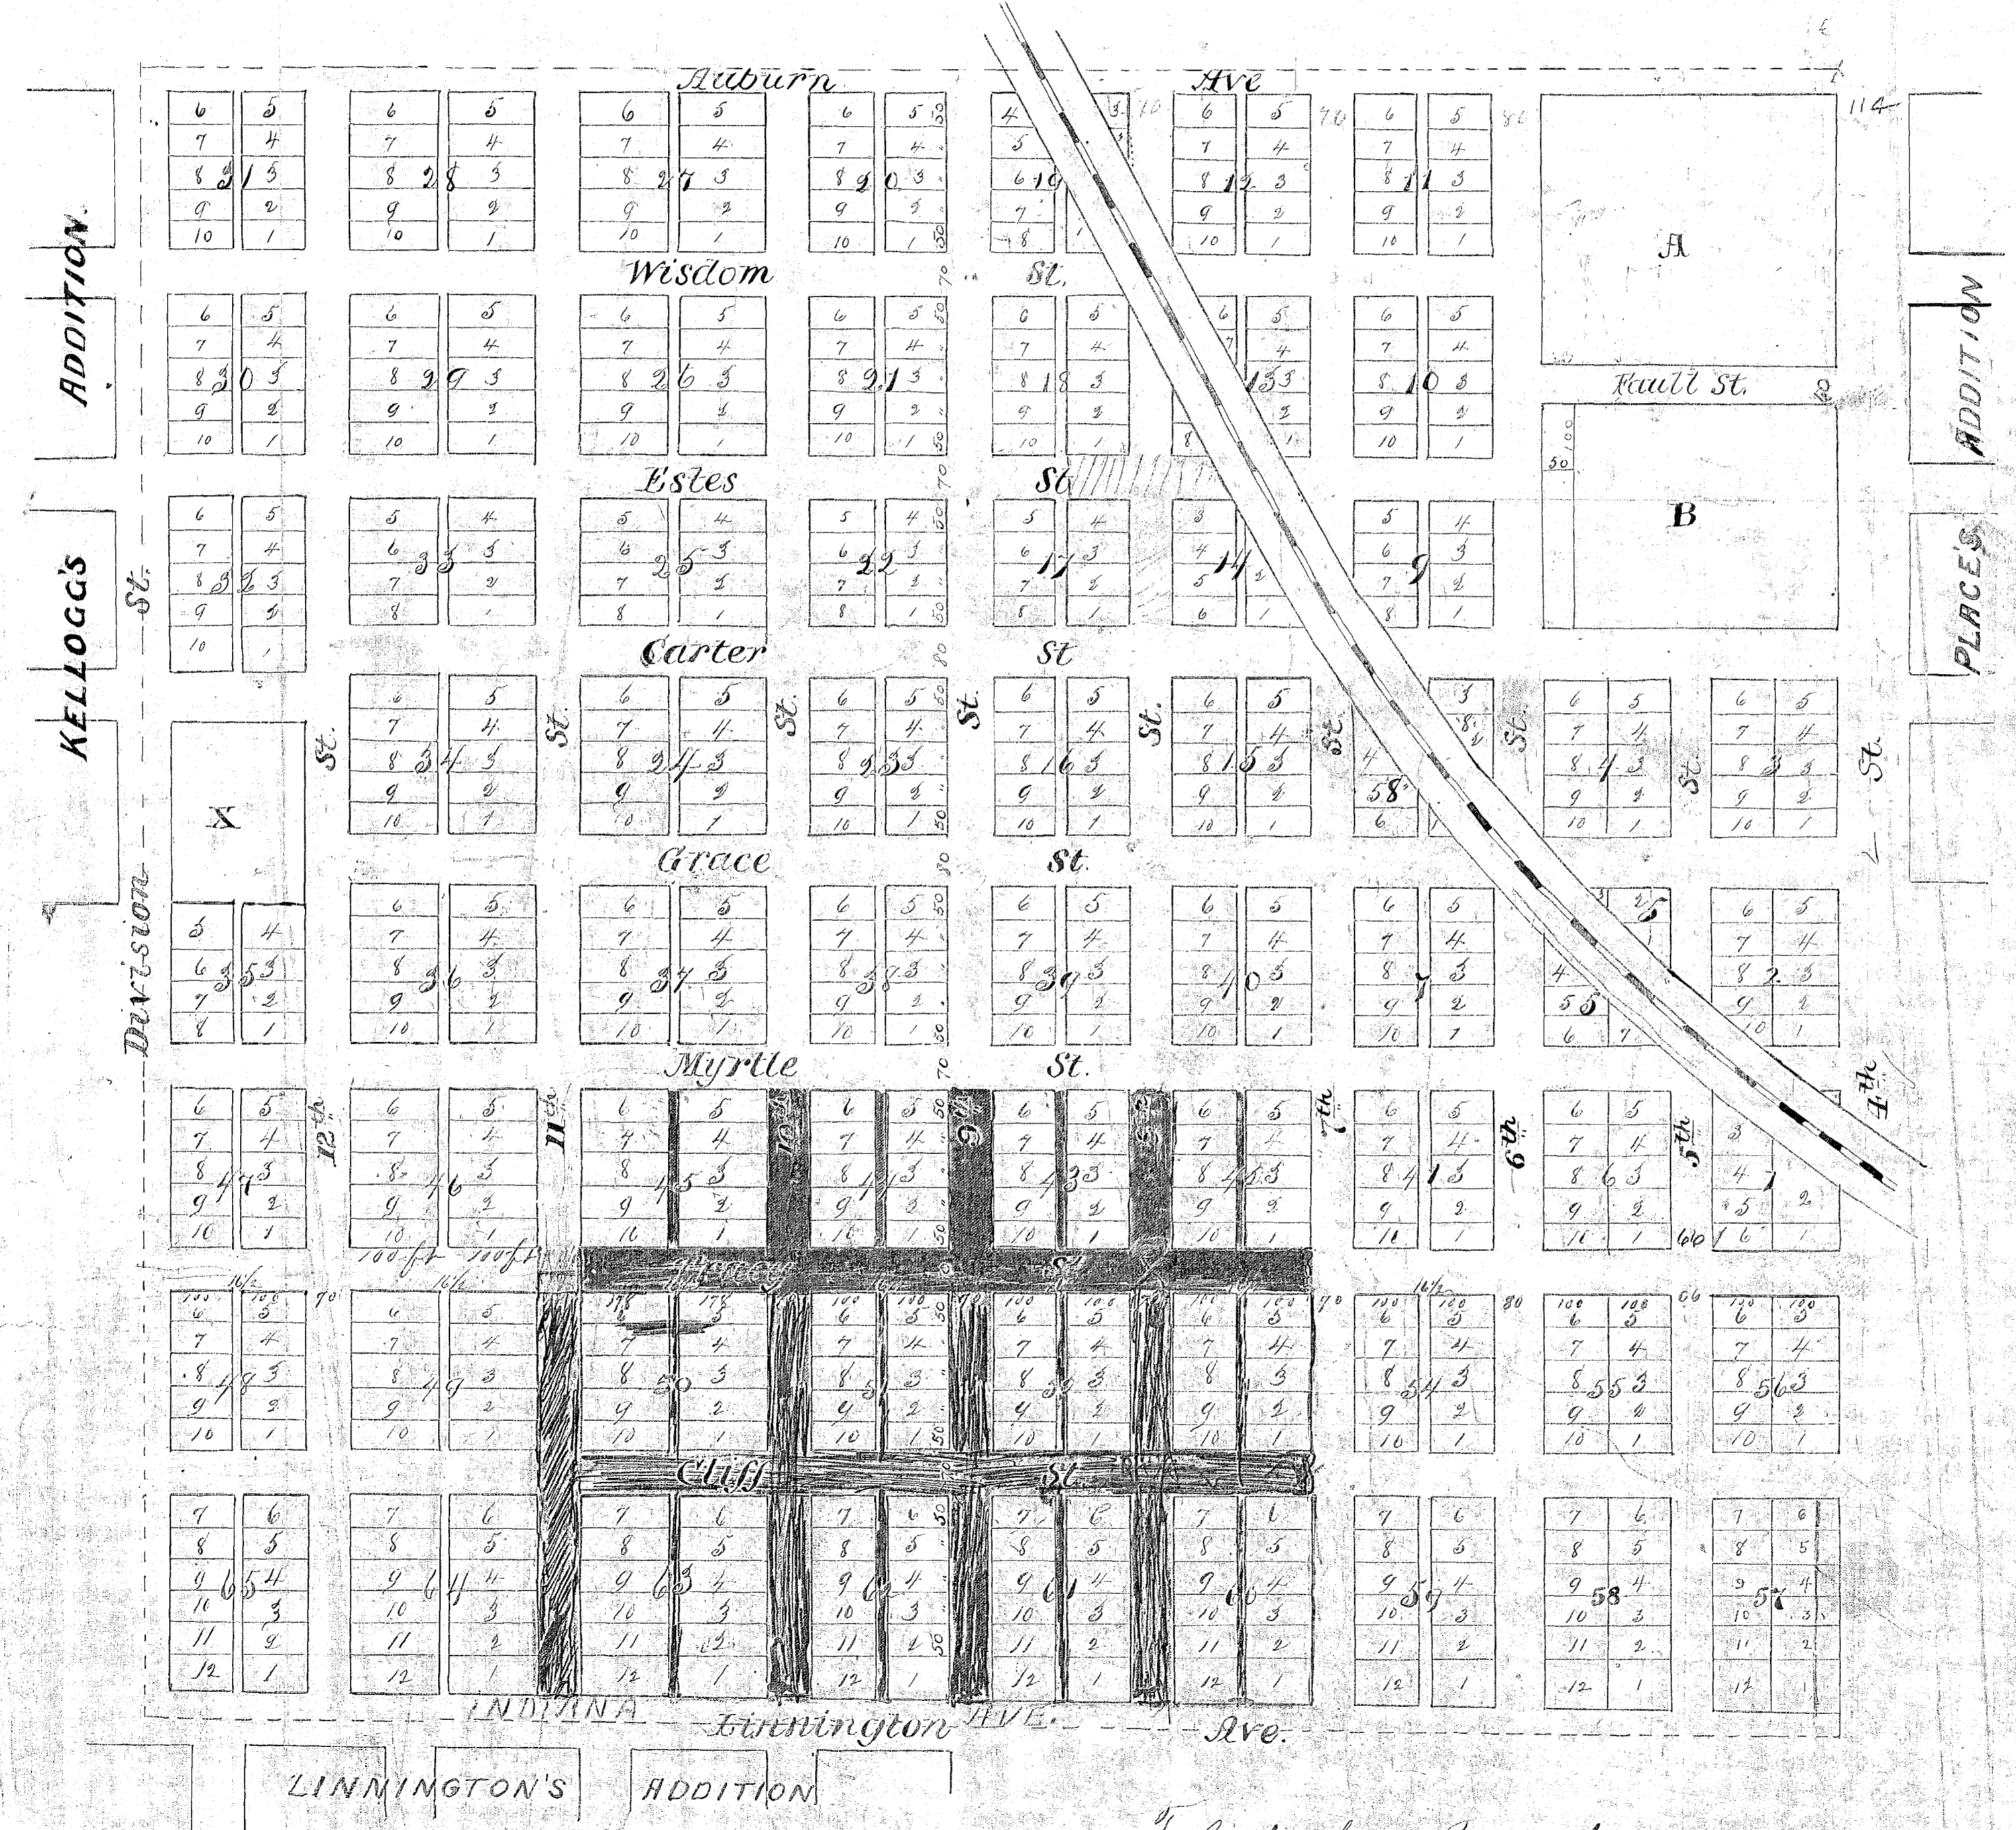

Ordinance 2139 Vacating Streets and alleys shown in
 Red and also recorded in Book 125 at page 2;
 Passed by the Council April 18th 1938
 Signed by J. Sturgill Mayor Commissioner
 & attested by Mable Nelson City Clerk.
 D. W. Nelson
 County Surveyor

Ordinance no. 2145 Vacating Streets and alleys shown in red and
 recorded in Book 126 at Pages 936-7 of Deeds. Passed by the Council
 August 1st 1938, and signed by J. O. Sturgill Mayor Commissioner
 the City of Baker, Oregon and attested by Mable Nelson City Clerk.
 Signed by D. W. Nelson County Surveyor this 28th
 December, 1938.

Filed for Record
 November 22nd 1886 Recorded in Vol. 15 Deeds of Deeds for Baker County, Ore.
 E. H. Mix County Clerk