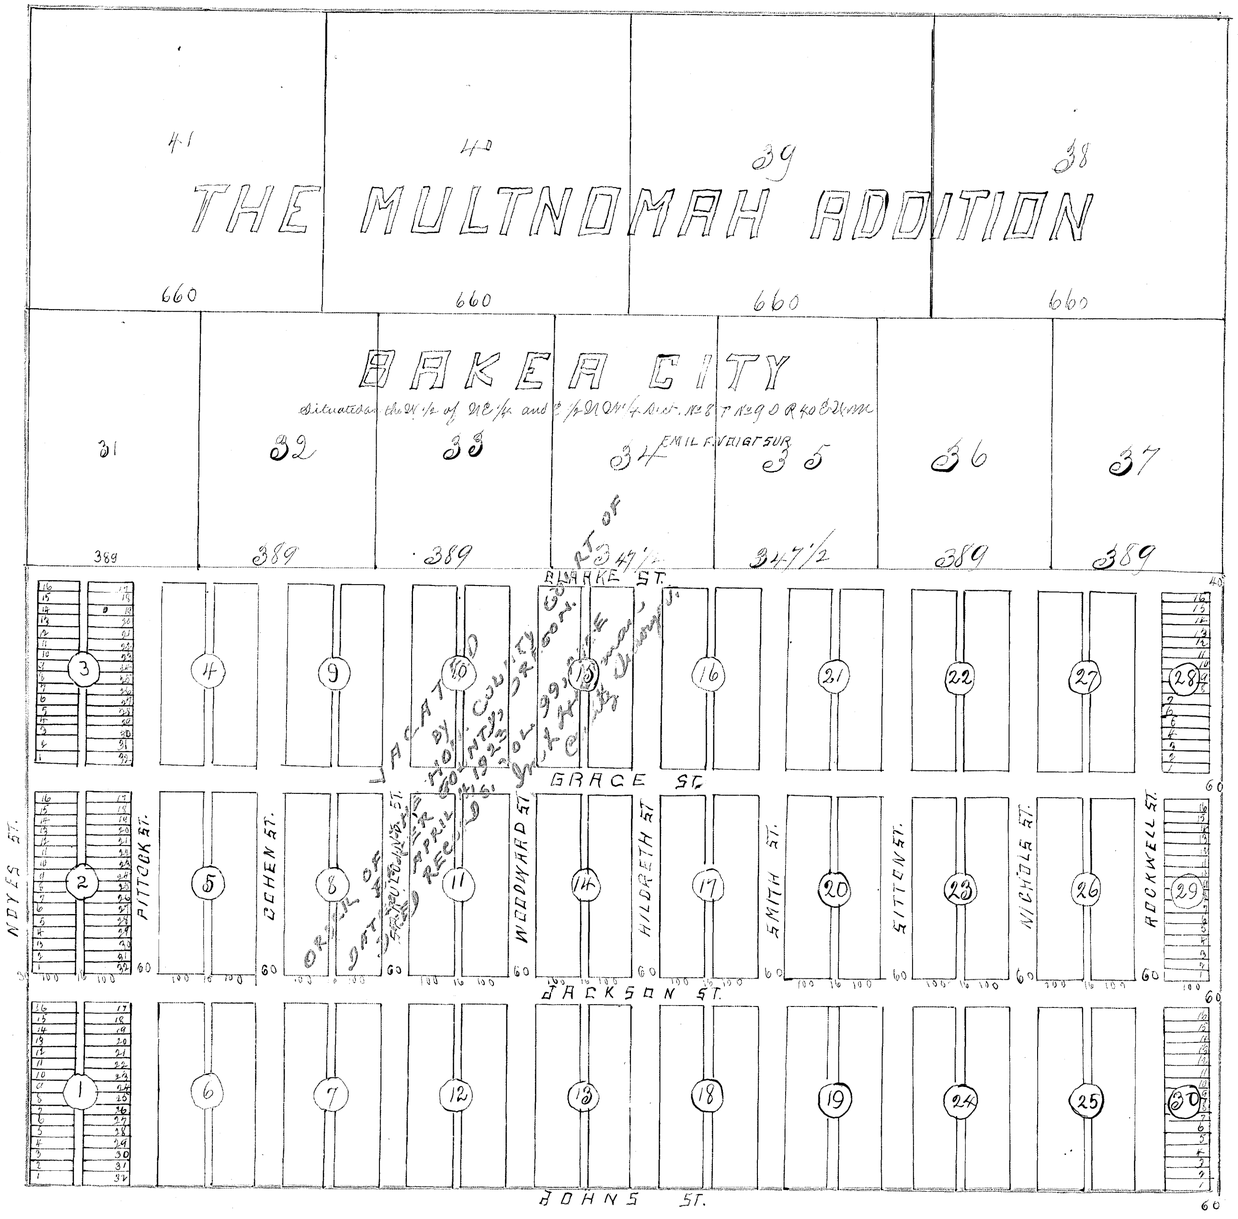
THE MULTNOMAH ADDITION
41
40
39
38
660
660
660
660
BAKER CITY
Situated on the W ½ of NE ¼ and E ½ NW ¼ Sect. No 8 T No 9 S R 40 E W.M.
EMIL F. VEIGT SUR.
31
32
33
34
35
36
37
389
389
389
347½
347½
389
389
CLARKE ST.
GRACE ST.
JACKSON ST.
JOHNS ST.
NOYES ST.
PITTOCK ST.
COHEN ST.
WOODWARD ST.
HILDRETH ST.
SMITH ST.
SITTON ST.
NICHOLS ST.
ROCKWELL ST.
3
4
9
10
15
16
21
22
27
28
2
5
8
11
14
17
20
23
26
29
1
6
7
12
13
18
19
24
25
30
60