

DETAIL
 LOT 5, SECTION 7 AND THAT PORTION OF LOT 39 OF
 THE SAW MILL GULCH CONSOLIDATED PLACER
 MINING CLAIM WITHIN SECTION 12, T 8 S, R 43 E
 AND SECTION 7, T 8 S, R 44 E
 LYING WESTERLY OF THE WESTERLY RIGHTS OF WAY
 LINE OF EAST EAGLE CREEK ROAD
 SCALE: 1" = 200'

**RECORD OF SURVEY
 FOR
 MAHAFFEY FAMILY TRUST**
 THE NE 1/4 OF SECTION 13 T 8 S, R 43 E, W.M.
 A PORTION OF THE SAW MILL GULCH CONSOLIDATED PLACER MINING CLAIM, LOT 39
 LOCATED WITHIN SECTION 12, T 8 S, R 43 E AND SECTION 7, T 8 S, R 44 E
 AND LOT 5 LOCATED SW OF EAGLE CREEK ROAD WITHIN SECTION 7
 T 8 S, R 44 E, W.M., BAKER COUNTY, OREGON
 2012

NARRATIVE




LINE TABLE

LINE NUMBER	BEARING	DISTANCE
11	N 89°57'18" E	2261.72'
15	S 83°18'13" E	148.07'
16	S 74°23'43" E	729.09'
17	S 71°33'03" E	74.44'
18	S 71°33'03" E	63.29'
19	S 22°01'07" W	89.67'
20	N 89°40'21" W	89.67'
21	N 89°40'21" W	276.24'
22	S 42°33'00" E	408.37'

REFERENCE DATA

- R1 - GLO PLAT AND NOTES (TOWNSHIP LINE) SURVEYED BY BALDWIN IN 1873 UNDER CONTRACT NO. 786
- R2 - GLO PLAT AND NOTES (RS 43E SUBDIVISION) SURVEYED BY BAIRD IN 1880 UNDER CONTRACT NO. 372
- R3 - GLO PLAT AND NOTES (RS 44E SUBDIVISION) SURVEYED BY BAIRD IN 1880 UNDER CONTRACT NO. 388
- R4 - GLO PLAT AND NOTES (S23) THE SAW MILL GULCH CONSOLIDATED PLACER CLAIM SURVEYED BY TOTT IN 1898 UNDER MINERAL CONTRACT NO. 303
- R5 - EAGLE CREEK ROAD - NUMBER 891 RECORDED 1948 IN DEED BOOK 130, PAGE 253 BAKER COUNTY, OREGON. THE LOCATION AND WIDTH ARE PRESCRIPTIVE BASED UPON EXISTING IMPROVEMENTS AT TIME OF SURVEY.
- R6 - SPARTA LANE ROAD - THE LOCATION AND WIDTH ARE PRESCRIPTIVE BASED UPON EXISTING IMPROVEMENTS AT TIME OF SURVEY.
- R7 - BARBORN AND SALE DEED B11 16 0067 ONE 1/4 SECTION 13 MAHAFFEY/BROSE TO MAHAFFEY FAMILY TRUST.
- R8 - BARBORN AND SALE DEED B05 16 0400 (GOVERNMENT LOT 5 & PORTION OF LOT 39, MS 2323) MAHAFFEY/BROSE TO MAHAFFEY/BROSE. (SEE NOTE UNDER NARRATIVE)
- R9 - BARBORN AND SALE DEED B05 16 0400 (GOVERNMENT LOT 5 & PORTION OF LOT 39, MS 2323) MAHAFFEY/BROSE TO BRAL. (SEE NOTE UNDER NARRATIVE)

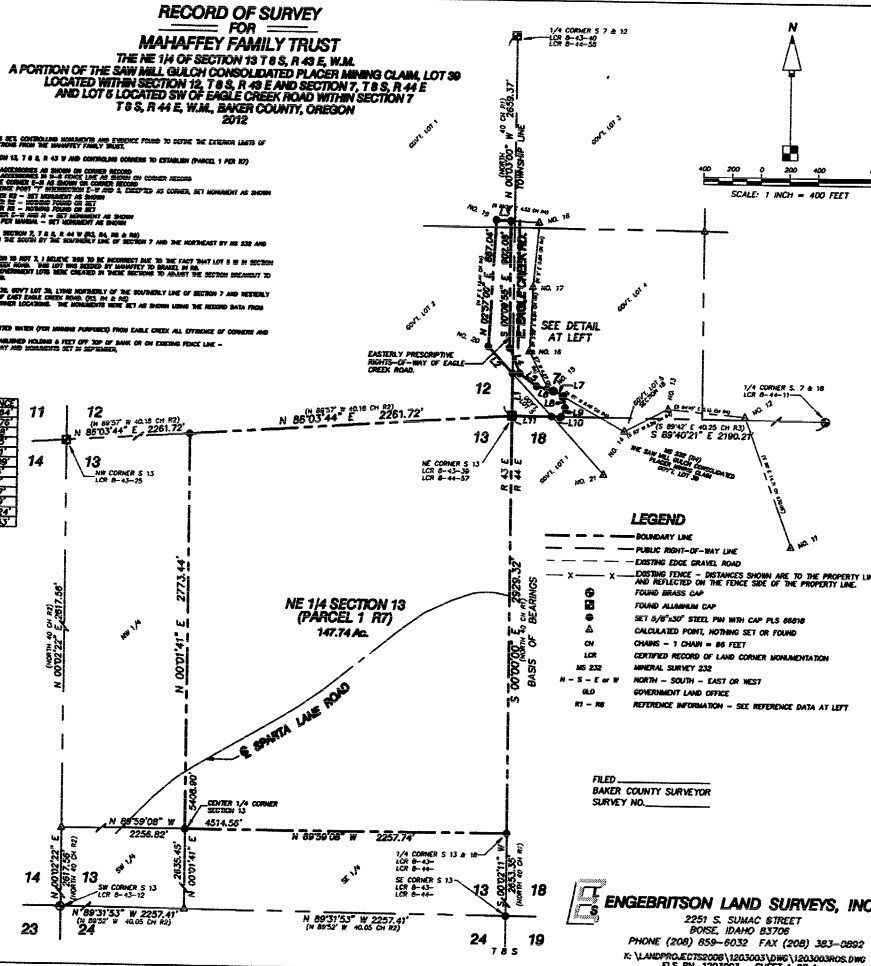

- LEGEND**
- BOUNDARY LINE
 - - - PUBLIC RIGHT-OF-WAY LINE
 - - - EXISTING EDGE GRAVEL ROAD
 - - - EXISTING FENCE - DISTANCES SHOWN ARE TO THE PROPERTY LINE AND REFLECTED ON THE FENCE SIDE OF THE PROPERTY LINE.
 - X X X FOUND BRASS CAP
 - ⊙ FOUND ALUMINUM CAP
 - ⊙ SET 5/8"X30" STEEL PIN WITH CAP PLS 68018
 - ⊙ CALCULATED POINT, NOTHING SET OR FOUND
 - CH - 1 CHAIN = 66 FEET
 - LOR - CERTIFIED RECORD OF LAND CORNER MONUMENTATION
 - MS 232 - MINERAL SURVEY 232
 - N = N or E or W
 - S = S or E or W
 - BLD - GOVERNMENT LAND OFFICE
 - R1 - R9 - REFERENCE INFORMATION - SEE REFERENCE DATA AT LEFT

FILED
 BAKER COUNTY SURVEYOR
 SURVEY NO. _____

ENGBRITSON LAND SURVEYS, INC.
 2251 S. SUMAC STREET
 ROOSE, IDAHO 83706
 PHONE (208) 859-6032 FAX (208) 383-0802
 K:\LANDPROJECTS\2008\1203003\DWG\1203003.MXD
 ELS PN 1203003 SHEET 1 OF 1