

Vacation

I hereby certify that in accord with Ordinance No 2172 passed by the City Council January 14 1941 Recorded Jan 15, 1941 in Book 129 at page 448-9 of the Deed Record in the Clerks office of Baker County Oregon vacating a portion of the adjoining property of Miller and Clegg said portion of ground is hereby vacated

D.W.O. Nelson
County Surveyor


Vacation

I Hereby Certify that in accord with an Ordinance No 2166 of 1940 passed by the City Council October 14 Recorded Oct 15th 1940 in Book 129 Page 245 of the Deed Record in the Clerks office of Baker County Oregon vacating a portion of the adjoining property of the L.D.S. Church said portion of ground is hereby vacated

D.W.O. Nelson
County Surveyor

I hereby certify that in accordance with an ordinance no 2170 passed by the City Council January 14 1941 and Recorded Jan 15-1941 in Book 129 at page 448 of the Deed Record in the Clerks office of Baker County Oregon vacating a portion of the adjoining property of R.R and Ethel H. Anderson a portion of said ground is hereby vacated.

D.W.O. Nelson
County Surveyor

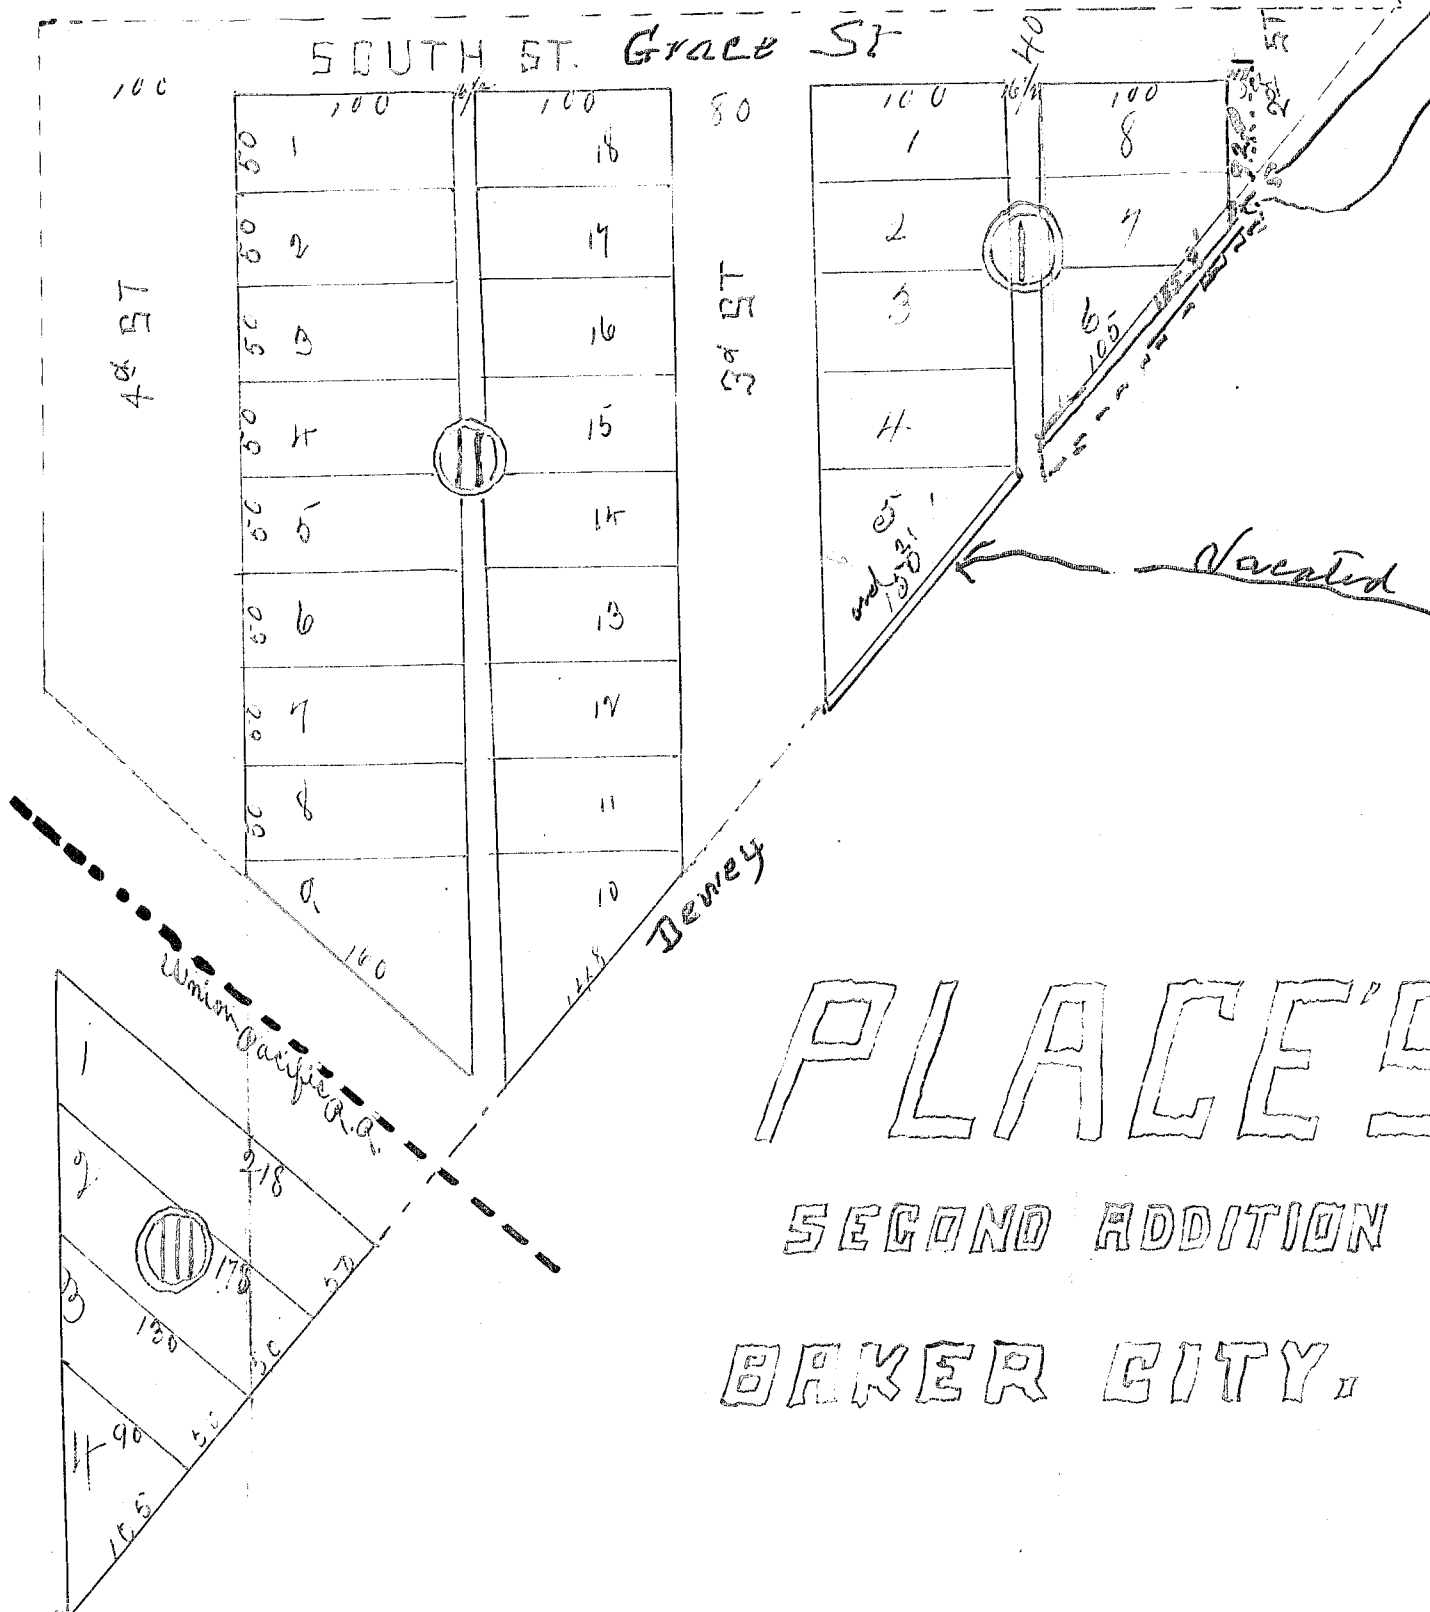

PLACE'S
SECOND ADDITION
BAKER CITY.