

SW COR. LOT 48 CEDAR ACRES ADD.

SOUTH 1/4 CORNER SEC. 9.

180 21
90 22
270 43

Preliminary Angle 90°08'

Nail in Pavement.

Temporary Reference Line 1236.77 "H" ST.

Fence Corner.

1236.93

Book 113 - Page 234

Sec. 16 - T. 9 S. - R. 4 E.

1238.05

IRRIGATION DITCH EASEMENTS

15' x 143'

NW 1/4 of NE 1/4 Sec. 16, T. 9 S., R. 4 E., W. M.

THIS AREA WAS THE FAULL ADDITION
TO BAKER CITY, NOW CITY OF BAKER.
BAKER, COUNTY, OREGON.

2 STEEL NAILS IN PAVEMENT ON E. OF CEDAR ST. IN YELLOW STRIPE, ONE FOOT APART.

The North Nail is in line with South Boundary of Faull Addition as Shown Hereon.

The South Nail is on a line 20 ft. North of and parallel with N. City Block S. J. J. Campbell Add.

S. Cedar St. 79 ft. and S. Perry St. 176 ft. Cedar St. 1340.35 ft. 2267.9

1272.70 between Nails CEDAR ST.

653.65

90° 21'

1242.32

89° 17'

1242.96

"E" ST.

1243.14


1223.22

10	11
9	12
8	13
7	14
6	15
5	16
4	17
3	18
2	19
1	20

CHESTNUT

10	11
9	12
8	13
7	14
6	15
5	16
4	17
3	18
2	19
1	20

CHERRY

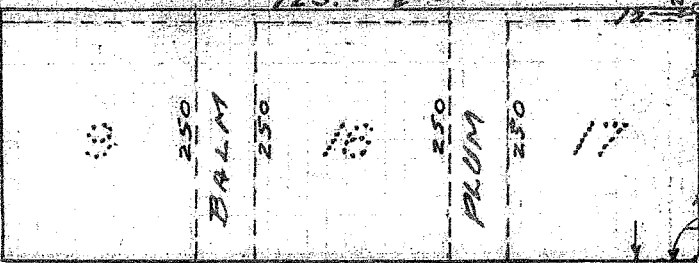

"BIRCH" ST. 1288.63

Preliminary Angle to South Nail on E. Cedar St. 89° 13'

LEGEND

o Indicates Steel Bar
1/2" x 2'-0"

SURVEY OF TRACT
Formerly Occupied by
FAULL ADDITION
Scale: 1" = 200' R.F. 1/2000.



Reference: Angle Iron
5 1/2' E. of & About 0.5' N. of
Fence Corner, 34.58'
from North Nail.

Preliminary Angle
Instrument on South
Nail, F.S. Nail on Cedar
Point 90° 07' to Nail at
D St. & Birch St.