Field Notes of Subdivision Sec 4-5 & 9 in T 8 S R 46 E W M

Surveyed for Joll Hewit & James McNut June 30 1888

The Corner to Sec 4-5-8 & 9 Thence South Var 20° E 8011 Chains the corner to 8-9-16 & 17 Thence North 1985 chains the 1/8 corner on South side S.W. 1/4 Sec 4 1/16 corner 3998 chains 1/16 corner in center W 1/2 Sec 4 1/8 corner on North side N.W. 1/4 Sec. 9 Thence Trun South 2003 chains Set Post for center N.W. 1/4 Sec 9 from which a Pine 10 inch Bears S 89° E 76 lks Thence East 6018 chains 1/8 corner on East side N.E. 1/4 the 1/4 Sec Corner on East Side Sec 9 Thence North 4006 chains N.E. Corn Sec 9 from which Trun South 2003 chains Set Post for 1/8 corn from which an asp 5 inch diameter Bears N 58° 30' W 43 links distant Thence West 2006 chains Set Post for 1/16 corne from which an asp 10 inches Bears S 48° W 82 links distant

J. W. Kimbrell Dept Co. Surveyor

Surveyed for Robt Eakin & C C Coffinberry July the 9th 1888

By J. W. Kimbrell County Surveyor Plat 1 No. 39

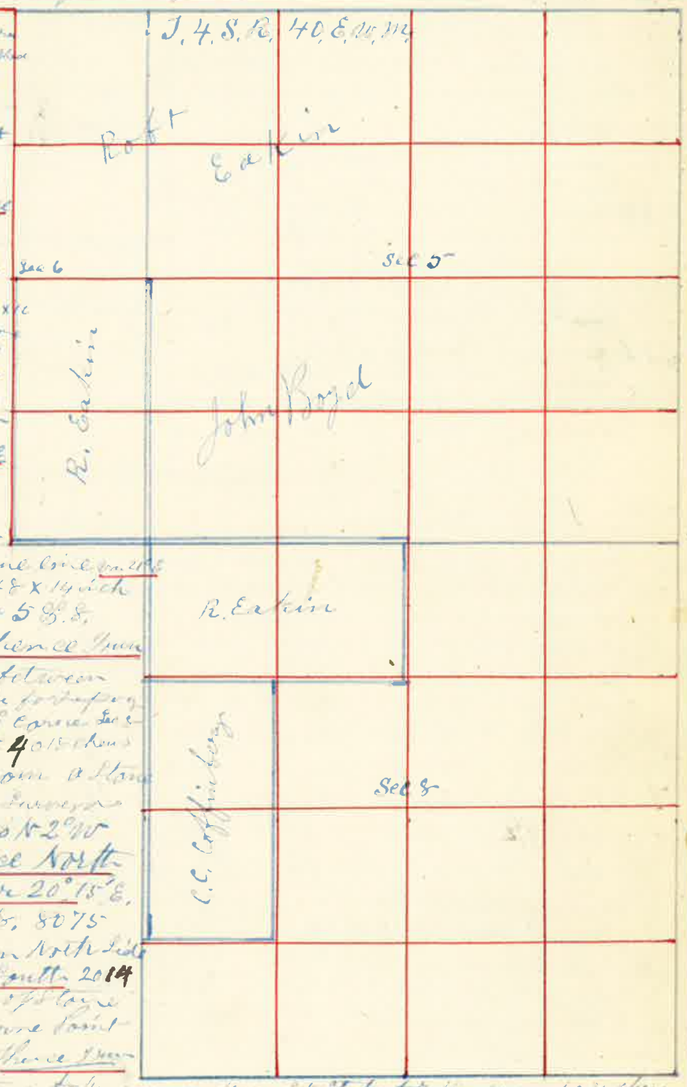

I commenced at the 1/4 Sec corn between Sec 7 & 8 a Stone marked Thence South Var 20° E 2000 chains Set Post for temporary 1/8 corne 4018 Corner to Sec 7-8-17 & 18 from which Trun North 2009 chains Set Stone marked for 1/8 corne 4018 chains 1/4 Sec corne Thence North 20 chains Set post for 1/8 corne 4018 chains Corner to Sec 5-6-7 & 8 a Stone 8 x 8 x 28 inches 20 inch in ground from which Trun South 2009 chains Set Stone 4 x 6 x 12 inches for 1/8 corne 4018 chains 1/4 Sec corne between Sec 7 & 8 Thence East 20 chains Set Stake for 1/16 corne 40 " Set Stake for temporary center 8012 chains 1/4 Sec corne on East side Sec 8. The N.E. Corner Sec 8 Thence Trun West between Sec 5 & 8 40 chains Set temporary Stake for 1/4 Sec corne 8036 chains the N.W. Corner Sec 8 from which Trun East on true line var 21° E 4018 chains Set Stone 7 x 8 x 14 inch for 1/4 Sec corne between Sec 5 & 8. The S.E. Corner Sec 8 Thence Trun East on Random line between Sec 8 & 17 40 chains Set Stake for temporary 1/4 Sec corne 8036 chains S.E. Corner Sec 8 from which Trun West at 4018 chains Set Stone for 1/4 Sec corne from a Stone Set by Moses Austin Co Surveyor Set for John Doffins Bears N 2° W 32 links distant. Thence North through Center Sec 8 Var 20° 15' E. 3965 chains Center Sec. 8. 8075 chains the 1/4 Sec corne on North side Sec 8 from which Trun South 2014 chains Set Stone in mound of Stone for 1/16 corne. The 1/8 corne Point on North side N.W. 1/4 Sec 8 Thence Trun South 2007 chains Set Stone for 1/16 corne 4020 Set Stake for 1/16 corne 6031 chains Set Stone for 1/16 corne The N.W. Corne Sec 8 Thence North 40 chains Set Stake for temporary 1/4 Sec corne 8090 chains Intersect North Boundary Sec 5 67 links East of corne to Sec 5-6-31 & 32 from which Trun South on true line var 21° E. 4060 chains Set Stone 7 x 8 x 18 inches for 1/4 Sec corn between Sec 5 & 6 8090 chains corne to Sec 5-6-7 & 8 Thence West 2000 Set Stake for temporary 1/8 corne 4024 chains 1/4 Sec corne on North side Sec 7 from which Trun East 2012 chains Set Stone marked 1/8 corne 4024 chains N.E. Corne Sec 7 T 4 S R 40 E W M

J. W. Kimbrell County Surveyor