Surveyed for John Erickson May 30 1889

By John W Kimbrell County Surveyor Plat No 79

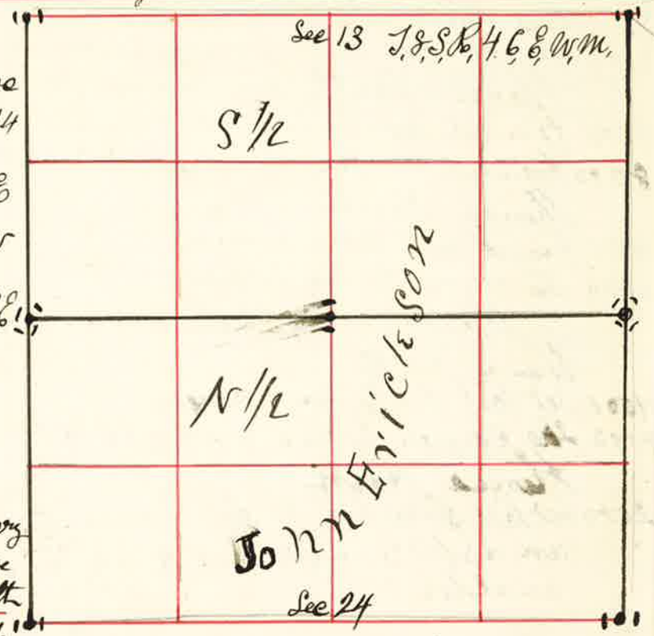

I Commenced at the 1/4 Sec Corner between Sec 13 & 24 Post from which a cottonwood 8 in brs N 10° E 342 lks dist a Poplar 6 inch brs S 50° W 442 lks thence North var 20° E

1757 Pine creek 114 lks wide runs East

2000 Set Temporary 1/16 Corner

4000 Set " " Post for Center

8024 Intersect North Boundary 12 lks East of 1/4 Sec corner from which I run South

6845 Set Post from which an asp 6 inches brs S 76° W 43 lks marked 1/16 B.T. " " 13 " " S 50½° E 92 " " 1/16 B.T.

The Corner to Sec 13=24=18&19 on Range Line thence North for the re-establishment of the 1/4 Sec corner on East Boundary Sec 13.

4000 Set Temporary 1/4 Sec Post

7910 The

4270 Pine creek 134 lks wide runs East

7910 the Corner to Sec 7=18=12&13. from which I run South

3955 Set Post for 1/4 Sec corner in mound of Stone from which a Pine 18 inches brs N 18° E 110 lks marked 1/4 B.T. an asp 10 5 " " S 40° W 80 " " 1/4 B.T.

5932 Set Post for 1/2 Corner

7910 the Corner to Sec 13=24=18&19

The 1/4 Sec corner on West Boundary Sec 13 thence East on 19.

4043 Intersect N & S line 20 lks North of 12th Stake at this Point

7487 Pine creek 173 lks wide runs North

8045 East Boundary 120 lks North of 1/4 Sec Corner.

The 1/4 Sec Corner bet Sec 13 & 24 thence East var 20° E

2000 Set Temporary 1/8 Corner

4014 Intersect East Boundary 44 lks South of Corner to Sec 13=24=18&19 from which I run West on Line

2007 Set Post in Mound of Stone for 1/8 Corner

4014 The 1/4 Sec Cor bet Sec 13 & 24

The 1/16 Corner in center S 1/2 Sec 13 thence East var 20° E

1168 Pine Creek 227 lks wide runs N. 20° E

2000 Set Post for Temporary center S E 1/4 Sec 13

4026 The 1/8 Corner on E Bdy, S E 1/4 Sec 13 from which I run West

2013 Set Post in Slough Marked 1/16 from which an asp 8 inches brs S 38° E 42 lks dist marked 1/16 B.T. " " 6 " " S 82° W 90 " " " 1/16 B.T.

The 1/4 Sec Corner on North Boundary Sec 24 thence South var 20° E

2000 Set Post for Temporary 1/16 Corner in Center N 1/2 Sec 24

4000 Set " " " 1/16 " " Center Sec 24

8046 Intersect South Boundary Sec 24 5 lks East of 1/4 Sec. Corner

The 1/4 Sec Corner bet Sec 13 & 24 from which a Poplar 12 inches brs West 120 lks thence East var 20° E

2000 Set Stake for Temporary 1/16 Cor in Center N 1/2 Sec 24

4020 Intersect N & S. line 8 lks South of 12th Stake at this Point

6003 Set Stake for Temporary 1/16 Corner in Center E 1/2 Sec 24

8025 Intersect East Boundary 5 lks South of 1/4 Sec Corner from which I run West on Line Are

2006 Set Post in Mound of Stone for Center E 1/2

4012 Set Post in " " " " Center Sec 24

6018 " " " Ground by the Side of Small Hawthorn Bush.

8025 West Boundary at 1/4 Sec Cor

The Center Sec 24 thence North

2001 thru Center N 1/2 Sec 24. a Post thence West

2008 Set Stake in Road for Center W 1/4 Sec 24. Temporary

J. W. Kimbrell County Surveyor