Surveyed for J. N. Sanders March 17 1887

by J. W. Kimbrell Dep't Co Surveyor Plat No. 1

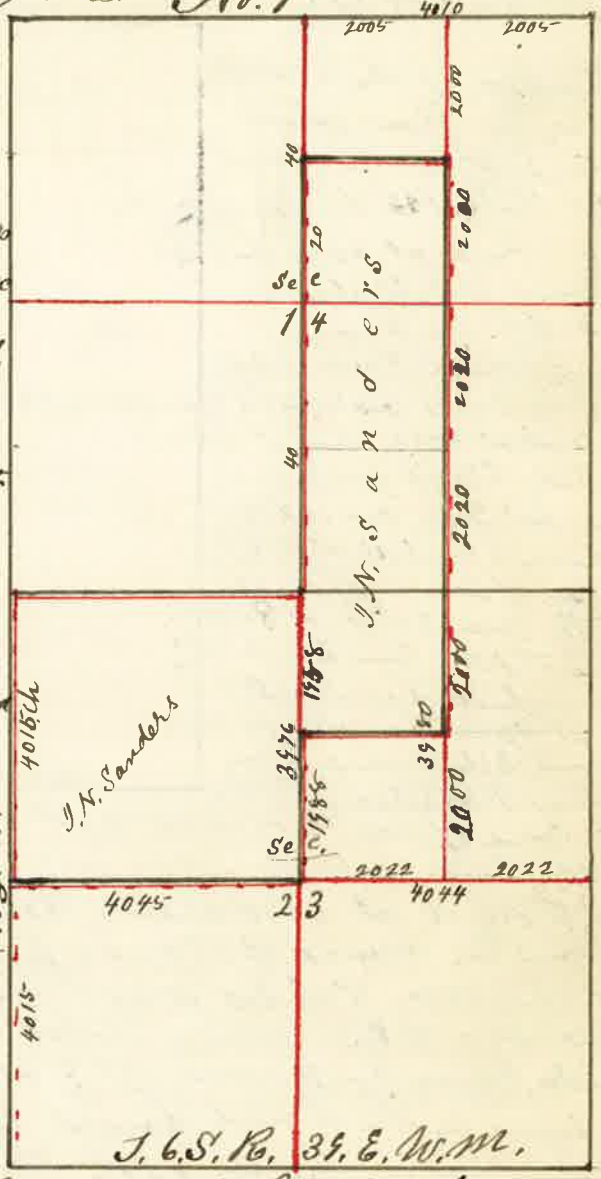

I Started at the corner to Sec.s 14 = 15 = 22 & 23 which is a Stake in mound of Earth.
from which I run South at 4030 Chains Powder River. found no 1/4 Sec corner at 8030 chains the Sec. corner to Sec.s 22 = 23 = 26 & 27. from which I run North on True line var 20° and at 4015 chains reestablished 1/4 Sec corne on North Bank of North Powder River 15 links from Rive Drove Red Fir Stake 4 in Diam with 3 1/2 feet long and Hand full of Stone Coal at Botton of Stake Pits East & west of Stake the mound of Earth around Stake.
from this corner I run East var 20° 15' E at 40 chains drove Temp. Stake for Cente of Sec. 23 at 8089 Chains the 1/4 Sec corne on East Side of Sec 23. from which I run west at 2022 chains Planted Pine Stake for 1/16 corne in mound of Earth Pits &c. and at 4044 chains Planted Stake for center of Sec 23 marked C.S. in mound of Earth with Pits &c. from which I run North at 20 chains set Temp. Stake for 1/16 corne at 3976 chains the 1/4 Sec corne on North Side of Sec 23 from which I run South and at 1988 Chains Planted Stake in mound of earth for 1/16 corne Pits &c. Thence East 20 chains and Planted Stake in mound of Earth Pits and &c for Center of N.E. 1/4 Sec. 23. I then Started at 1/4 Sec Corne on South Side of Sec 14 from which I run North 80 chains to 1/4 Sec. corne on North Side of Sec. 14 Thence South var 20° E at 20 chains Planted a Stake 4 in Diamte & 2 in long Stone Coal at Botton of Stake in mound of Earth Pits &c. I then Started at 1/4 sec. corne on South Sid of Sec. 14 from which I run East at 4010 chains the sec corne to Sec 11 = 12 = 13 & 14 Stake in mound Thence West 2005 chs Thence South 20 chains Drove Stake Built mound Pits &c. for Cente of N.E. 1/4 Sec 14 Thence South var 20°30' E 10040 chains to corne Established in Center of N.E. 1/4 Sec. 23

J. W. Kimbrell Dep't County Surveyor