


Surveyed for John Elliot & Chas. Harris May 26 1890

by J. W. Kimbrell county surveyor Plat No. 111

I commenced at the 1/4 Sec corner bet Sec 25 & 30 on Guide Meridian T1N Range 35 & 40 E thence South bet Sec 25 & 30 var 22° 55' E

T. 1. N. 36. 40. E

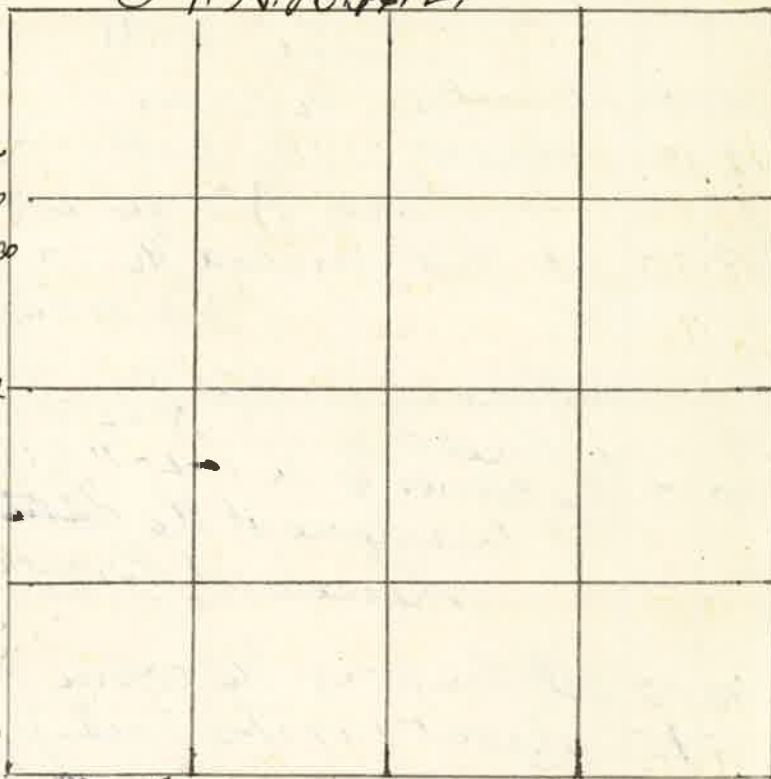

20 00 Set temporary 1/6 corner
40 10 intersect 24 lks west of the corner to be 30-31-25 & 36 thence North
20 05 set stone 20x12x6 for 1/6 corner
40 10 the 1/4 Sec corner

I commenced at the 1/4 Sec corner bet Sec 30 & 31 from which a line 12 inches bears S 61° W 24 lks dist.

thence North through center Sec 30 var 20° E
18 27 North Hillside on left bank of Clark's creek runs W 840 lks telescope measurement to flag on north side of creek

21 66
20 00 set temporary 1/6 corner for center S 1/2 Sec 30
40 00 set temporary 1/6 corner for center Sec 30
60 00 set temporary 1/6 corner for center N 1/2 Sec 30
80 20 intersect 700 lks west of the 1/4 Sec corner bet Sec 19 & 30 from which I run S 10° W on true line through center

I commenced at the corner to Sec 19-30-24 & 25 - thence East bet Sec 19 & 30 var 21° E

19 54 set temp 1/6 corner
40 38 intersect 28 lks south of 1/4 Sec corner bet Sec 19 & 30 I commenced at the 1/4 Sec corner bet Sec 29 & 30 thence West through center Sec 30 var 21° E

44 76 I intersect E of W line 112 lks south of first center Sec 30
64 56 set temporary 1/6 corner
81 76 I intersect 55 lks south of the 1/4 Sec corner bet Sec 25 & 30
I commenced at the corner to Sec 25-36-30 & 31 on S.M. thence East bet Sec 30 & 31 var 22 1/2° E

19 72 set temporary 1/6 corner
38 12 I intersect the 1/4 Sec corner bet Sec 30 & 31 west on line
16 70 set stone for 1/6 corner on S 1/2 Sec 30 W 1/4 Sec 30
33 12 the corner to Sec 30-31-25 & 36 I commenced at the 1/6 corner on south boundary S W 1/4 Sec 30 thence with var 22 1/2° E

20 00 set temporary 1/6 corner for center S W 1/4
41 00 I intersect 35 lks East of 1/6 corner in center W 1/2 Sec 30 S 0° 30' E on true line
20 50 set stone 24x13x5 inches for 1/6 corner
41 00 the 1/6 corner

Note for the 1/6 corner in center S 1/2 Sec 30 which is in the bed of Clark's creek could plant no corner from which true corner an alder 6 inches bears N 11° 30' W 15 lks dist an alder 4 " " N 170° E 13 " "

also The 1/6 corner on North boundary N W 1/4 Sec 30 a stone in mound of stone from which a Hawthorn 3 ins dia bears S 23° E 7 lks dist for the center of W 1/2 Sec 30 is a post from which a Hawthorn 4 ins dia bears S 2° W 12 lks dist -

J. W. Kimbrell county surveyor