

Surveyed for John Obryant May the 30 1890  
by J.W. Kimball county surveyor Plat No. 112

T 6 S 16 38 E W M

I commenced at  
the corner to Sec.

1-12-6 & 7  
on Range Line  
bet Sec 38 & 39

Township 6, S,  
Thence North bet.  
Sec 1 & 6

Var 20° E

20 00 Set temporary 1/16 corner

40 06 Intersect 16 lles  
East of the 1/4 Sec cor.  
bet Sec 1, 8, 6

Thence S. 14' E  
on line line

20 03 Set post for 1/16 corner 7812

40 06 ~~The corner to Sec 1 & 6~~  
I commenced at the 1/4 Sec corner bet Sec 1 & 6  
thence west through the center Sec 1  
Var 20° E

20 00 Set temporary 1/16 corner opposite corner E 1/2 Sec 1

40 00 Set temporary 1/16 corner for center Sec 1

60 00 Set temporary 1/16 corner for center W 1/2 Sec 1

81 35 Intersect 5 & 6 lles North of the 1/4 Sec corner bet Sec 1 & 2  
S 89° 38' E on line line

20 34 Set 1/16 corner for center W 1/2 Sec 1


40 68 Set 1/16 corner for center Sec 1

61 02 Set 1/16 corner for center E 1/2 Sec 1

81 35 The 1/4 Sec cor bet Sec 1 & 6  
I commenced at the 1/4 Sec corner bet Sec 1 & 2  
thence South 3° 30' E Var 20° S

20 00 Set temporary 1/16 corner

40 05 Intersect 10 lles E of the corner to Sec 2-11 & 12  
J.W. Kimball county surveyor

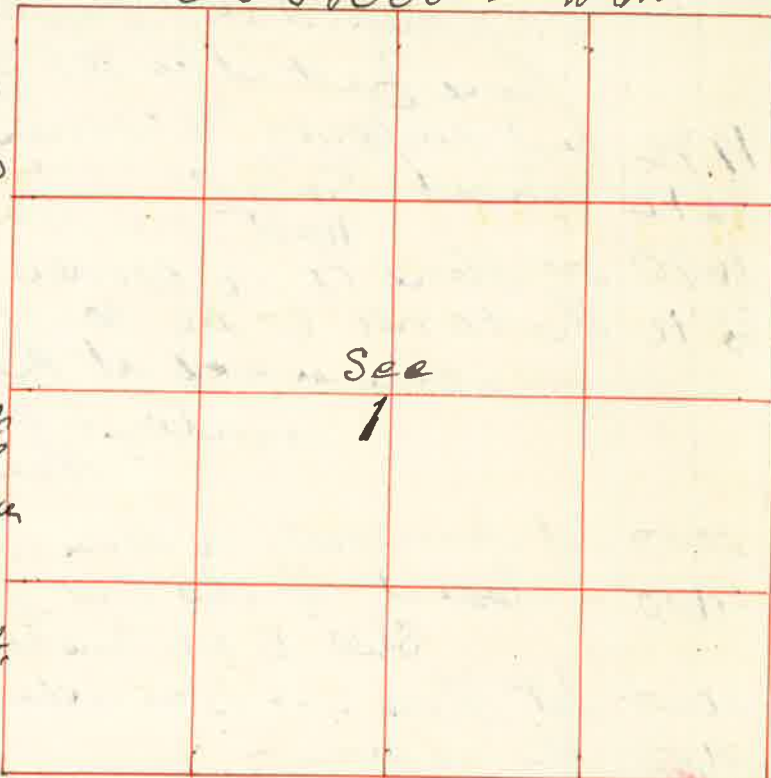

Surveyed for R.L. Smith & Wilson Bros. June the 3<sup>rd</sup> 1890  
by J.W. Kimball county surveyor Plat No 113

T. 6, S. 16, 39, E. W. M.

Commenced at the

Corner to Sec 29-30-31 & 32  
Thence South bet Sec 31 & 32  
Var 20° E

20 00 Set temporary 1/16 corner

31 00 Road E & W

31 85 Rail fence E & W

40 00 found No 1/4 Sec cor  
and Set temporary  
1/4 Sec corner

55 50 Rough runs East  
North Powder River 127 lles wide runs East

58 53 Set temporary 1/16 corner

60 00 Intersect South boundary 6 lles East of the corner to Sec 29-30-31 & 32

79 92 Thence No 1' E on line line bet Sec 31 & 32

19 98 Set post for 1/16 corner

39 96 Set Stone 18x7+6 inch for 1/4 Sec corner bet Sec 31 & 32

59 94 Set Stone 14x7+6 " " 1/16 corner

79 92 The corner to Sec 29-30-31 & 32

I commenced at the 1/4 Sec corner bet Sec 31 & 32  
thence East through center Sec 32  
Var 20° E

40 12 The Center Sec 32

80 25 The 1/4 Sec corner bet Sec 32 & 33

I commenced at the 1/4 Sec corner bet Sec 29 & 32  
thence South through the center Sec 32  
Var 20° E

800 Road E & W

2000 Set temporary 1/16 corner for center N 1/2 Sec 32

40 00 Set temporary 1/16 corner for center Sec 32

80 00 The 1/4 Sec corner bet Sec 5 & 32  
thence Run North and Set permanent corners  
as indicated on My Random line

