


CERTIFIED RECORD OF LAND CORNER MONUMENTATION

History of original corner establishment:

Original corner set by William B. Barr, under GLO Contract No. 388, approved December 31, 1881.
Record states: Set stake 4 ft. long 4 in diam 18 in ground for $\frac{1}{4}$ sec corner from which:
Pine, 48 in. diam., bears West, 20 lks. dist.
Pine, 30 in. diam., bears S 60° E, 47 lks. dist.


Subsequent Monumentation:

Corner was reestablished by Barry B. Barbour, LS 1051, as described by Survey No. 6-38-010, filed December 6, 1979, in the records of the Baker County Surveyor.
Record states: Found one large rotten [sic] pine stump near two others. Measured record and found charcoal and 4" x 3" x 2" charred wood about 18" below the ground. Area of East BT has been bladed.
Unable to set corner. At single proportionate distance set 2½" x 30" galvanized pipe and brass cap marked (as shown below): Set pipe 25" in the ground. No rock in the area.
From which, by magnetic declination of N20°E:
A 14" tamarac [sic] bears S50°E, 104.5 ft. scribed 1/4S30 BT.
An 11" tamarac [sic] bears N36°W, 55.4 ft. scribed T6SR37E BT.

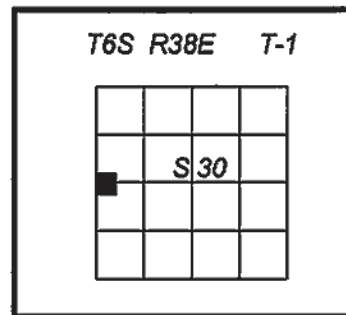

Description of corner evidence found:

Found 2½ ins. diam. iron pipe, projecting 3 ins. above ground, with 2½ ins. diam. brass cap, marked as shown:
From the recovered monument I find the Barbour bearing trees:
A tamarack, 20 ins. diam., bears S. 50° E., 104.5 ft. dist., alive and healthy, with full scribe visible on open double blaze.
A tamarack, 15 ins. diam., bears N. 36° W., 55.4 ft. dist., alive and healthy, with healed double blaze.

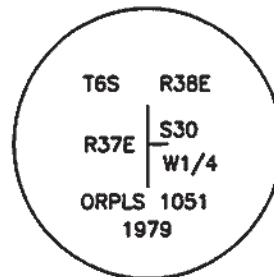

Description of monument and accessories I established to perpetuate original location of this corner:

New bearing trees:
A tamarack, 8 ins. diam., bears N. 2° E., 11.1 ft. dist., mkd. 1/4 S30 BT.
A white fir, 5 ins. diam., bears S. 86° E., 36.0 ft. dist., mkd. X BT on double blaze.

Set guard post ±5 ft S'y with Land Survey Monument (54-9) and Property Boundary (54-2) signs attached.

All new bearing trees are marked on a single blaze unless noted otherwise and have a nail with a brass washer stamped "LS 2648" right side center for distance measurements.

Painted 6 ins. red bands and added Bearing Tree (54-3) and Land Survey Monument (54-9) signs as needed to all bearing trees.


Auto C/A geographic position:
Lat. 45°00'48.1" N
Long. 118°06'56.9" W

I hereby certify that the corner is monumented and accessories taken as described, using a Warren Knight staff compass, set with 15° East declination, and steel tape on October 7, 2014.

Witnesses: Brenda Johnson




Deceased

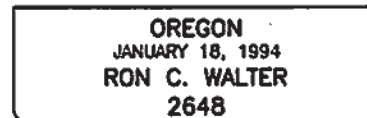

Renewal Date: June 30, 2016



William R. Wells

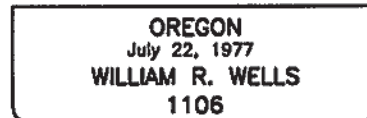

Renewal Date: June 30, 2016

FILED Feb. 25, 2015
BAKER COUNTY SURVEYOR
SURVEY NO. 6-37-4
6-38-31

NOTE: See "Explanation for Successor Certifying Surveyor" statement in Narrative of Record of Survey, CS 6-38-28, filed concurrently with this Land Corner Record.