

CERTIFIED RECORD OF LAND CORNER MONUMENTATION

History of original corner establishment:

Original corner set by William B. Barr, under GLO Contract No. 388, approved December 31, 1881.

Record states: Marked Fir 18 in diam for $\frac{1}{4}$ sec corner from which:

Fir, 14 in. diam., bears N 5°W, 5 lks. dist.

Fir, 6 in. diam., bears S 78° E, 28 lks. dist.

Subsequent Monumentation:

Corner was remonumented by Barry B. Barbour, LS 1051, as described by Survey No. 6-38-008, filed December 6, 1979, in the records of the Baker County Surveyor.


Record states: Found 24" white fir snag scribed " $\frac{1}{4}$ S" on west face. A 16" white fir snag scribed " $\frac{1}{4}$ S BT" bears N 5°W, 3.2 ft.

Unable to set pipe at snag, measured North 6.0 ft. from center of snag and set Witness Corner for $\frac{1}{4}$ section corner. Set 2 $\frac{1}{2}$ " x 30" galvanized pipe and brass cap marked (as shown below): Set pipe 25" in the ground and mound of stone around to cap.

From which, by magnetic declination of N20°E:

A 15" tamarac bears N76°E, 37.5 ft. scribed W.C. 1/4 S19 BT.

A 9" tamarac bears S22°W, 17.7 ft. scribed W.C. T6SR37E BT.

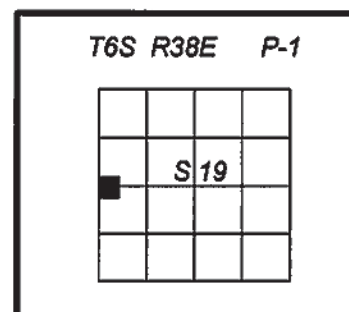

Description of corner evidence found:

Found 2 $\frac{1}{2}$ ins. diam. iron pipe, projecting 4 ins. above ground, with 2 $\frac{1}{2}$ ins. diam. brass cap, marked as shown:

GLO Bearing and corner trees not found.


From the recovered monument I find the Barbour bearing trees:

A tamarack, 16 ins. diam., bears N. 76° E., 37.5 ft. dist., alive and healthy, with healed double blaze.

A tamarack, 10 ins. diam., bears S. 22° W., 17.7 ft. dist., alive and healthy, with healed double blaze.

Found guard post ± 4 ft N'ly with Land Survey Monument (54-9) and Property Boundary (54-2) signs attached.

Corner tree location falls in 1 ft. wide by 6 ins. deep creek, courses S. 20° E.

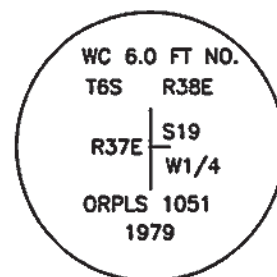

Description of monument and accessories I established to perpetuate original location of this corner:

New bearing trees:

A tamarack, 11 ins. diam., bears S. 42 $\frac{1}{2}$ ° E., 74.1 ft. dist., mkd. WC 1/4 S19 BT.

An Englemann spruce, 6 ins. diam., bears S. 15° E., 45.3 ft. dist., mkd. X BT on double blaze.

Set guard post ± 5 ft S'ly with Property Boundary (54-2) sign attached.

Note: All bearings and distances to W.C. Monument.

All new bearing trees are marked on a single blaze unless noted otherwise and have a nail with a brass washer stamped "LS 2648" right side center for distance measurements.

Painted 6 ins. red bands and added Bearing Tree (54-3) and Land Survey Monument (54-9) signs as needed to all bearing trees.

Auto C/A geographic position:

Lat. 45°01'40.0" N

Long. 118°06'56.3" W

I hereby certify that the corner is monumented and accessories taken as described, using a Warren Knight staff compass, set with 15° East declination, and steel tape on October 7, 2014.

Witnesses: Kristina Powell, Brenda Johnson, Justin Seal and Chance Johnson

REGISTERED
PROFESSIONAL
LAND SURVEYOR

Deceased

OREGON
JANUARY 18, 1994
RON C. WALTER
2648

Renewal Date: June 30, 2016

REGISTERED
PROFESSIONAL
LAND SURVEYOR

William R. Wells

OREGON
July 22, 1977
WILLIAM R. WELLS
1106

Renewal Date: June 30, 2016

FILED Feb. 25, 2015

BAKER COUNTY SURVEYOR

SURVEY NO. 6-37-3

6-28-30

NOTE: See "Explanation for Successor Certifying Surveyor" statement in Narrative of Record of Survey, CS 6-38-28, filed concurrently with this Land Corner Record.