

CERTIFIED RECORD OF LAND CORNER MONUMENTATION

History of original corner establishment:

Original corner set by William B. Barr, under GLO Contract No. 388, approved December 31, 1881.

Record states: Set stake 4 ft long 4 in diam 18 in ground for $\frac{1}{4}$ sec corner. from which
Fir, 6 in. diam., bears N 50°E, 26 lks. dist.
Tamarack, 24 in. diam., bears S 30° W, 23 lks. dist.

Subsequent Monumentation:

Corner was remonumented by Barry B. Barbour, LS 1051, as described by Survey No. 6-38-003, filed December 6, 1979, in the records of the Baker County Surveyor.


Record states: Found no trace of wood post. Found 26" tamarac [sic] with "1/4 S BT" visible.

Found loose piece of fir with "BT" and old stump hole, N50°E, about 17 ft. Measured N30°E, 15.2 ft.

At center of above described point set $2\frac{1}{2}$ " x 30" galvanized pipe and brass cap marked (as shown below): Set pipe 24" in the ground and mound of stone around to cap.

From which, by magnetic declination of N20°E:

A 17" fir bears N77°E, 15.8 ft. scribed 1/4 S18 BT.

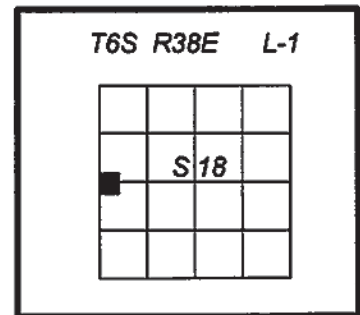

Description of corner evidence found:

Found $2\frac{1}{2}$ ins. diam. iron pipe, projecting 6 ins. above ground, with rock collar, and $2\frac{1}{2}$ ins. diam. brass cap, marked as shown:


From the recovered monument I find the original bearing tree remains:

A tamarack snag, ± 12 ft. tall, bears S. 30° W. 15.2 ft. dist., with BT visible on open blaze.

And accessories mkd. by Barbour:

A Douglas fir, 20 ins. diam., bears N. 77° E., 15.8 ft. dist., alive and healthy, with scribing visible on mostly healed double blaze.

Found guard post ± 5 ft N'y with Attention (54-4) sign; added Property Boundary (54-2) sign.

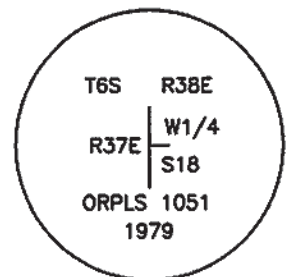

Description of monument and accessories I established to perpetuate original location of this corner:

New bearing trees:

A white fir, 13 ins. diam., bears N. $48\frac{1}{2}$ ° E., 22.9 ft. dist., mkd. XBT.

A lodgepole pine, 13 ins. diam., bears S. 80° E., 64.1 ft. dist., mkd. 1/4 S18 BT.

A white fir, 8 ins. diam., bears S. 47° E., 25.7 ft. dist., mkd. X BT on double blaze.

Set guard post ± 5 ft S'y with Property Boundary (54-2) sign attached.

All new bearing trees are marked on a single blaze unless noted otherwise and have a nail with a brass washer stamped "LS 2648" right side center for distance measurements.

Painted 6 ins. red bands and added Bearing Tree (54-3) and Land Survey Monument (54-9) signs as needed to all bearing trees.

Auto C/A geographic position:

Lat. 45°02'31.8" N


Long. 118°06'56.6" W

I hereby certify that the corner is monumented and accessories taken as described, using a Warren Knight staff compass, set with 15° East declination, and steel tape on October 11, 2014.

Witnesses: Kristina Powell, Brenda Johnson, Justin Seal and Chance Johnson




Deceased

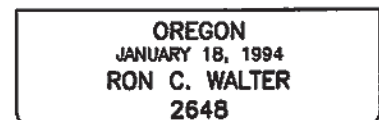

Renewal Date: June 30, 2016



William R. Wells

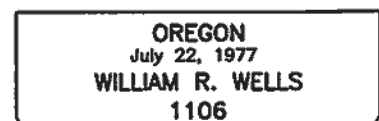

Renewal Date: June 30, 2016

FILED Feb. 25, 2015
BAKER COUNTY SURVEYOR
SURVEY NO. 6-37-1
6-38-28

NOTE: See "Explanation for Successor Certifying Surveyor" statement in Narrative of Record of Survey, CS 6-38-28, filed concurrently with this Land Corner Record.