

LEGEND

- FOUND ORIGINAL CORNER EVIDENCE AND SET MONUMENT AS DESCRIBED ON U.S.F.S. FORM R6-7100-57.
- SET MONUMENT AS DESCRIBED ON U.S.F.S. FORM R6-7100-57 BY SURVEY.
- ▲ CORNER SET BY HANLEY ENGINEERING MARCH 30, 1981
- ◆ CORNER RESET IN APRIL, 1981
- [] METERS
- () RECORD DATA FROM ORIGINAL SURVEY
- ⑤ SECTION NUMBERS

BASIS OF BEARING


SOLAR OBSERVATIONS:
7-24-79
8-7-79
9-24-79

MEAN MAGNETIC DECLINATION

N 20° 00' E

REFERENCE MATERIAL

FIELD BOOKS NO. 1-B
ORIGINAL G.L.O. PLATS
AND NOTES.

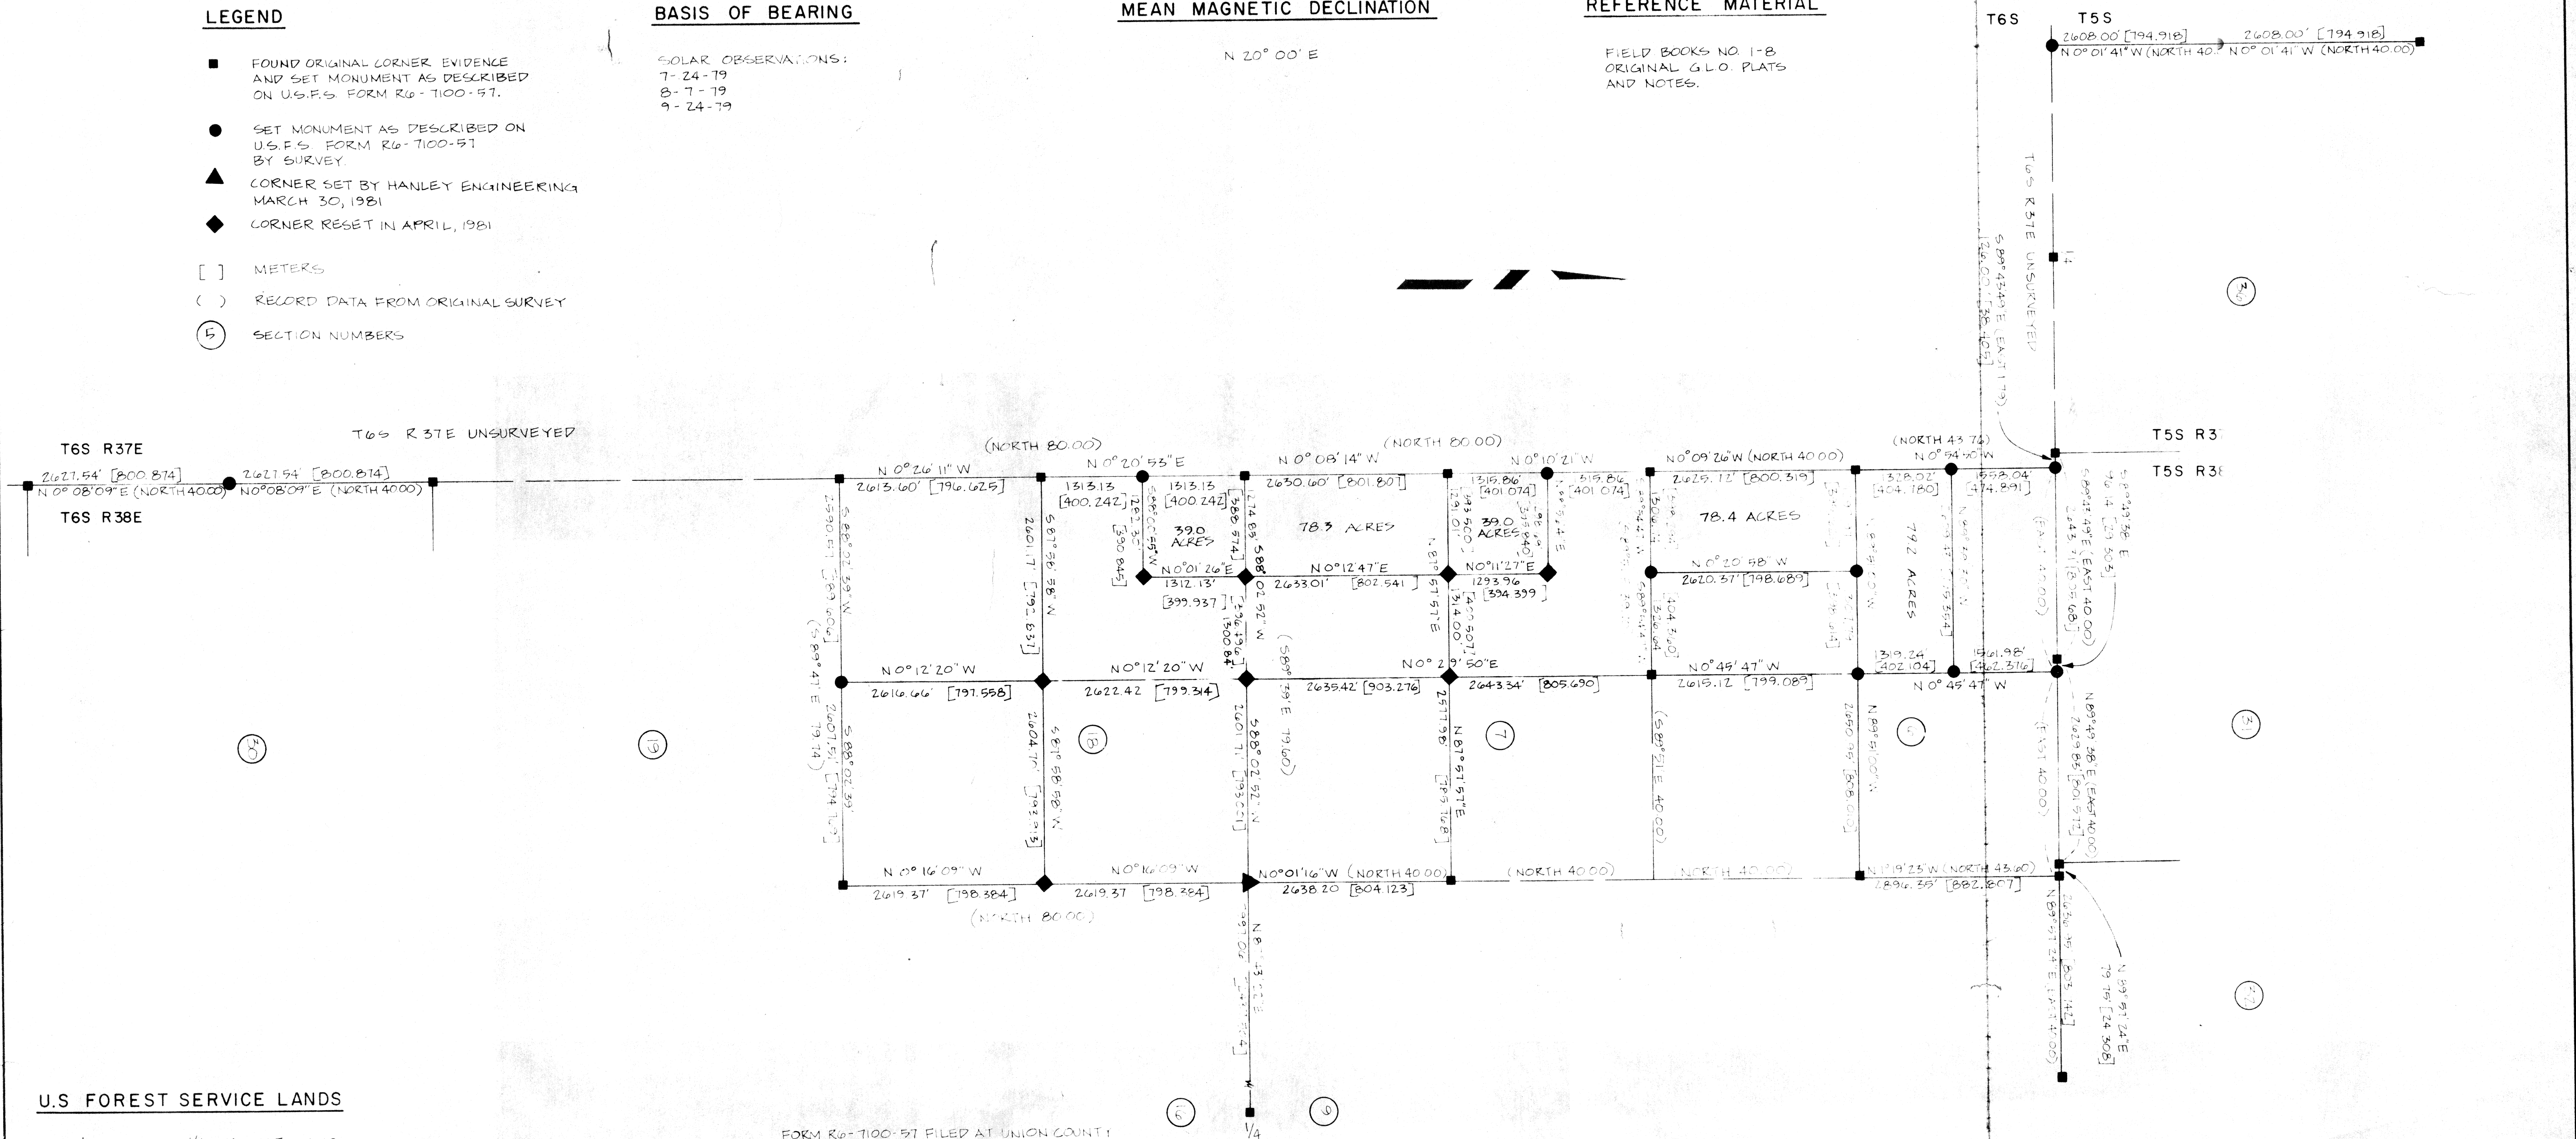

U.S. FOREST SERVICE LANDS

NW 1/4 OF THE NW 1/4 OF SECTION 18
SW 1/4 OF THE NW 1/4, W 1/2 OF THE SW 1/4 OF SECTION 7
S 1/2 OF THE NW 1/4, W 1/2 OF THE SW 1/4 OF SECTION 6

FORM R6-7100-57 FILED AT UNION COUNTY SURVEYORS FOR THE STANDARD INDEX FILE NUMBER: T5S, R37E, V-21, X-21, Z-21, Z-23 AND Z-25. T5S, R38E, Z-3, Z-5, Z-7, AND Z-9. T6S, R38E, A-1, A-3, A-5, B-1, B-3, C-1, C-2, C-3, C-5, E-1, E-2, E-3, F-1, F-2, G-1, G-2, G-3, G-5, J-1, J-2, J-3, J-5, J-11, K-1 AND L-5.

FORM R6-7100-57 FILED AT BAKER COUNTY SURVEYORS FOR THE STANDARD INDEX FILE NUMBER: T6S, R38E, K-2, L-1, L-3, N-1, N-3, N-5, P-1, R-1, T-1, V-1 AND X-1.

NOTE: NEW R6-7100-57S FILED AT UNION COUNTY SURVEYORS FOR STANDARD INDEX FILE NUMBER F-2, G-2, G-3, J-2, J-3, & L-5 MONUMENTS RESET IN APRIL, 1981.

NOTE: NEW R6-7100-57S FILED AT BAKER COUNTY SURVEYORS FOR STANDARD INDEX FILE NUMBER K-2 & L-3 FOR MONUMENTS RESET IN APRIL, 1981.

I, BARRY B. BARBOUR, a registered land surveyor in the State of Oregon, hereby certify that this plat and the notes hereon, or attached, are a correct representation of a survey I performed during July — October, 1979, for the U.S. Forest Service, in accordance with the Statutes of the State of Oregon and with the Articles of the Contract.

Barry B. Barbour

Barry B. Barbour
Registered Land Surveyor
Oregon License #051

Barry B. Barbour

REVISED SURVEY MAP: APRIL, 1981

HANLEY ENGINEERING HAD INFORMATION FOR AN UNRECORDED MONUMENT FOR CORNER TO SECTIONS 7, 8, 17 & 18. THEY REMONUMENTED THIS MONUMENT & I AGREED WITH THEIR POSITION. I RESET MY EFFECTED MONUMENTS & HAVE REVISED MY SURVEY.

Barry B. Barbour
BARRY B. BARBOUR
PLS. 1051
APRIL 30, 1981

amended map - originally filed Dec. 6, 1979

FILED June 22, 1981
BAKER COUNTY SURVEYOR
SURVEY NO. 6-38-1

MAP OF SURVEY
SECS 18, 7, 6 T6S R38E
ON 8 BAKER COUNTIES, OREGON
FOR U.S. FOREST SERVICE

1" = 100' BARRY B. BARBOUR
LAND SURVEYOR