


CERTIFIED RECORD OF LAND CORNER MONUMENTATION

Index File No. L-1

History of original corner establishment:

Corner was originally established W. B. Barr, under G.L.O. contract No. 388, in September, 1881. Surveyors General's notes state: "Set stake 4 ft. 4 in. diam. 18 in. in ground for 1/4 sec corner from which Fir 6 in. diam. bears N50°E, 26 lks. dist. Tamarack 24 in. diam. bears S30°W, 23 lks. dist."

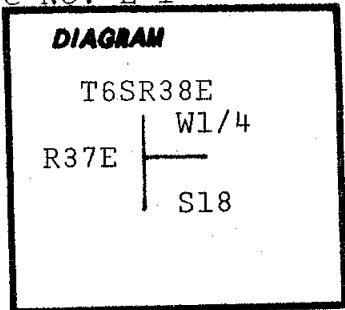


Description of corner evidence found:

Found no trace of wood post. Found 26" tamarac with "1/4 S BT" visible. Found loose piece of fir with "BT" and old stump hole, N50°E, about 17 ft. Measured N30°E, 15.2 ft.

Description of monument and accessories | established to perpetuate the original location of this corner:


At center of above described point set 2 1/2" x 30" galvanized pipe and brass cap marked; Set pipe 24" in the ground and small mound of stone around to cap. From which, by magnetic declination of N20°E; A 17" fir bears N77°E, 15.8 ft. scribed 1/4 S18 BT. Placed 54-3 and brass washer stamped PLS 1051 on BT. Placed 54-3 on old BT. Location tag on tree 10' South. Painted blazes red and 6" red band around. Placed 54-2 and 54-4 on steel fence post 5' North of corner.

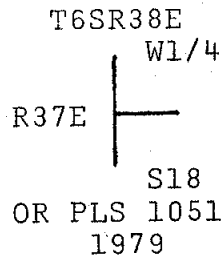


I hereby certify that the above corner monument was reestablished as herein described.

Witnesses: Frank Sherwood
Robert S. Stevens

August 8, 1979

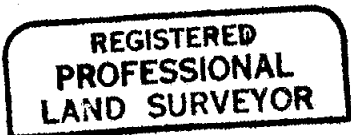

Barry B. Barbour

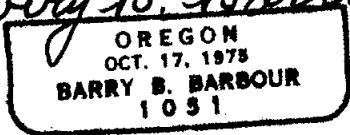

Office of.....County Surveyor.....County of.....Baker
State of.....Oregon....., I hereby certify that the within instrument was filed in this office
for record on the...6th day of...December....., 1979
..... by *Thomas J. Hanley*
(COUNTY OFFICIAL) (DEPUTY)

Form R6-7100-57 (9/71)

FILED Dec. 6, 1979
BAKER COUNTY SURVEYOR
SURVEY NO. 6-38-3

☆ GPO—798-276