


CERTIFIED RECORD OF LAND CORNER MONUMENTATION

Index File No. N-1

History of original corner establishment:

Corner was originally established by W. B. Barr, under G.L.O. contract No. 388, in September, 1881. Surveyors General's notes state: "Set stake 4 ft. long 4 in. diam. 18 in. in ground for corner to sec. 13, 18, 19, 24. from which Tamarack 16 in. diam. bears S72°E, 23 lks. dist. Fir 10 in. diam. bears S8°W, 24 lks. dist. Fir 8 in. diam. bears N39°W, 20 lks. dist. Fir 24 in. diam. bears N38°E, 25 lks. dist."

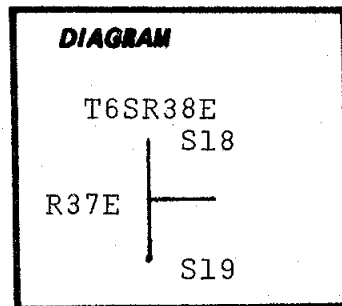

Description of corner evidence found:

Found no trace of wood post. Found 24" tamarac down with good scribing. Measured N07°W, 15.2 ft. No trace of 3 other BTs. 54-5s on NW BT, and on tree 25' east. 54-3 on down BT. Corner falls 10' west of jeep trail.

Description of monument and accessories I established to perpetuate the original location of this corner:

At center of above described point set 2 1/2" x 30" galvanized pipe and brass cap marked; Set pipe 24" in the ground. No rock in the area.

From which, by magnetic declination of N20°E: A 6" tamarac bears N68°E, 35.2 ft. scribed T6SR38E S18 BT. A 6" lodgepole pine bears S67°E, 41.2 ft. scribed T6SR38E S19 BT. A 9" fir bears S60°W, 21.8 ft. scribed T6SR37E BT. A 5" pine bears N34°W, 13.1 ft. scribed T6SR37E BT. Placed 54-3s and brass washers stamped PLS 1051 on BTs. Painted blazes red and 6" red band around. Placed 54-2 and 54-4 on steel fence post 5' South of corner.

T6SR38E
S18
R37E
S19
OR PLS 1051
1979

REGISTERED
PROFESSIONAL
LAND SURVEYOR

Barry B. Barbour

OREGON
OCT. 17, 1975
BARRY B. BARBOUR
1051

I hereby certify that the above corner monument was reestablished as herein described.

Witnesses: David L. Landers
Robert S. Stevens

July 27, 1979

Office of..... County Surveyor..... County of..... Baker
State of..... Oregon..... I hereby certify that the within instrument was filed in this office
for record on the 6th day of December....., 1979
..... by *Thomas J. Hanley*
(COUNTY OFFICIAL) (DEPUTY)

Form R6-7100-51 (9/71)

FILED Dec 6, 1979

☆ GPO—798-276

BAKER COUNTY SURVEYOR

SURVEY NO. 6-38-5