


CERTIFIED RECORD OF LAND CORNER MONUMENTATION

Index File No. R-1

History of original corner establishment:

Corner was originally established by W. B. Barr, under G.L.O. contract No. 388, in September, 1881. Surveyors General's notes state: "Set stake 4 ft. long 4 in. diam. 18 in. in ground for corner to sec. 19, 24, 25, 30. from which Tamarack 6 in. diam. bears S53°E, 17 lks. dist. Fir 20 in. diam. bears S5°W, 51 lks. dist. Fir 40 in. diam. bears N20°E, 20 lks. dist. Pine 10 in. diam. bears N18°W, 35 lks. dist."

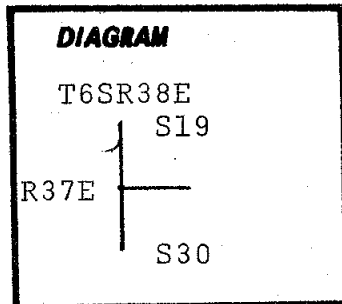


Description of corner evidence found:

Found 13" tamarac with partially open blaze and visible scribing. 48" fir with top blaze open and readable. Measured N55"E, 11.2 ft. where fir is N20°E, 12.7 ft. approximately to blaze. Old BTs have 54-3s.

Description of monument and accessories I established to perpetuate the original location of this corner:

At center of above described point set 2 1/2" x 30" galvanized pipe and brass cap marked: Set pipe 25" in the ground and small mound of stone around to cap. From which, by magnetic declination of N20°E: A 6" tamarac bears N37°E, 59.6 ft. scribed T6SR38E S19 BT. A 10" black pine bears S69°E, 69.6 ft. scribed T6SR38E S30 BT. A 10" fir bears S75°W, 12.7 ft. scribed T6SR37E BT. Placed 54-3s and brass washers stamped PLS 1051 on BTs. Painted blazes red and 6" red band around. Placed 54-2 and 54-4 on steel fence post 5' South of corner.

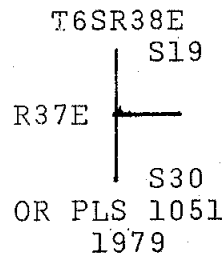

I hereby certify that the above corner monument was reestablished as herein described.

Witnesses: David L. Landers
Robert S. Stevens

July 23, 1979



Office of.....County Surveyor.....County of.....Baker.....
State of.....Oregon....., I hereby certify that the within instrument was filed in this office
for record on the...6th day of...December....., 19..79
.....by.....Thomas J. Henley.....
(COUNTY OFFICIAL) (DEPUTY)

Form R6-7100-57 (9/71)

FILED Dec. 6, 1979
BAKER COUNTY SURVEYOR
SURVEY NO. 6-38-9

☆ GPO—798-278