


CERTIFIED RECORD OF LAND CORNER MONUMENTATION

Index File No. V-1

History of original corner establishment:

Corner was originally established by W. B. Barr, under G.L.O. contract No. 388, in September, 1881. Surveyors General's notes state: "Set stake 4 ft. long 4 in. diam. 18 in. in the ground for corner to Sec. 25, 30, 31, 36. from which Black Pine 10 in. diam. bears N5°W, 8 lks. dist. Black Pine 10 in. diam. bears N70°E, 24 lks. dist. Tamarack 4 in. diam. bears S63°E, 15 lks. dist. Tamarack 5 in. diam. bears S20°W, 8 lks. dist."

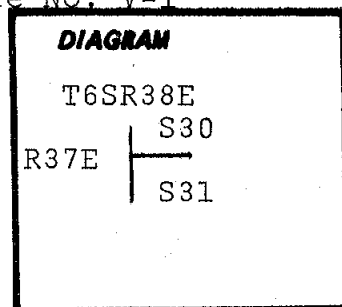


Description of corner evidence found:

Found 27 x 4 x 4 inch wood post with scribing visible on 3 sides. Old Location tag on tree 5' North. No trace of 4 BTs. Shaved ground and found rotten bottom of post. Corner is 7-8 ft. west of fence.

Description of monument and accessories I established to perpetuate the original location of this corner:


At center of above described post set 2 1/2" x 30" galvanized pipe and brass cap marked; Set pipe 24" in the ground and small mound of stone around to cap. Buried wood post alongside. From which, by magnetic declination of N20°E: A 15" fir bears N61°E, 54.4 ft. scribed T6SR38E S30 BT. An 8" fir bears S76°E, 51.1 ft. scribed T6SR38E S31 BT. A 12" fir bears S44°W, 23.2 ft. scribed T6SR37E BT. No good tree in NW quadrant. Painted blazes red and 6" red band around. Placed 54-3s and brass washers stamped PLS 1051 on BTs. Location tags 5' North and 5' SW of corner. Placed 54-2 and 54-4 on steel fence post 5' South of corner.

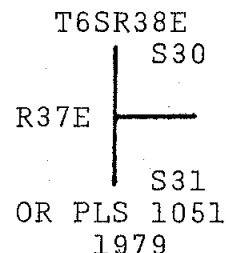

I hereby certify that the above corner monument was reestablished as herein described.

Witnesses: David L. Landers
Robert S. Stevens

July 23, 1979

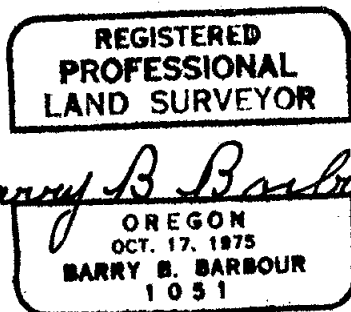

Office of.....County Surveyor.....County of.....Baker.....
State of.....Oregon....., I hereby certify that the within instrument was filed in this office
for record on the 6th day of December....., 1979
.....by.....*Thomas J. Hendley*.....
(COUNTY OFFICIAL) (DEPUTY)

Form R6-7100-57 (9/71)

FILED Dec. 6, 1979
BAKER COUNTY SURVEYOR
SURVEY NO. 6-38-11

☆ GPO—798-276