

CERTIFIED RECORD OF LAND CORNER MONUMENTATION

History of original corner establishment:

Corner established by W. B. Barr under GLO contract no. 388 dated May 7, 1881.


Surveyor General records state:

Marked basalt rock 16 x 8 x 8 for corner to sections 7, 8, 17 and 18, from which:

A pine 30 in diam bears N 38° E, 86 lks dist.

A pine 40 in diam bears N 58° W, 61 lks dist.

Raised mound of rocks as per instructions.

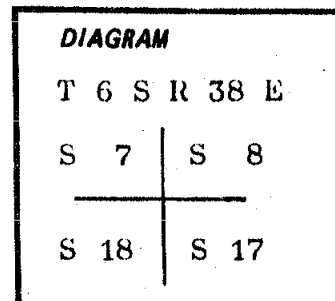

Description of corner evidence found:

Found a pipe, 1" in diameter 30" long and pointed on one end, in place and bent over from which a brass cap monument by ORLS 1051, 1979, bears N 80° 46' E, 78.42 feet and a projected fence intersection bears N 31° 34' W, 18.51 feet. This pipe is the identical monument located by James Hanley in 1951 and 1952 and in the same location pointed out by Del Snode, long time resident and ditch walker in the immediate area.

Note: See attached affidavit sworn by Mr. Snode.

Description of monument and accessories established to perpetuate the original location of this corner:

Set a 2½ inch brass cap on a 1 inch iron pipe 31 inches long and projecting 4 inches out of the ground with a surrounding rock mound.

Brass cap marked thus:

T 6 S R 38 E	
S 7	S 8
S 18	S 17
LS	3-30
1206	1981

I hereby certify that the above described corner monument was properly established under my supervision on March 30, 1981, and witnessed by Brad Gordon, Tom Fisk and Jim DeMastus.



Office of..... County of.....
 State of..... I hereby certify that the within instrument was filed in this office
 for record on the..... day of....., 19.....
 by
 (COUNTY OFFICIAL) (DEPUTY)

Form R6-7100-57 (9/71)

FILED March 30 1981
 BAKER COUNTY SURVEYOR
 SURVEY NO. 6-38-14