

CERTIFIED RECORD OF LAND CORNER MONUMENTATION

HISTORY OF ORIGINAL CORNER ESTABLISHMENT:

Corner originally established by Timothy W. Davenport under GLO contract number 102, dated July 20, 1863. Surveyor General records states:

Set post corner to Secs 2,3,34 and 35 made mound of earth and drove charred stake as per inst.

DESCRIPTION OF CORNER EVIDENCE FOUND:

Found no evidence of the GLO Corner monument or accessories.

See Survey dated May 20, 2002 for Wes Williams

DESCRIPTION OF MONUMENT AND ACCESSORIES I ESTABLISHED TO PERPETUATE THE ORIGINAL LOCATION OF THIS CORNER:

At a position determined by survey, I set a 2 1/2"x 30" aluminum pipe with aluminum cap marked as shown below, 28" in the ground, from which;

NEW BEARING OBJECTS:


A 5/8"x30" iron pin with 1 1/2" aluminum cap marked "BGB SURVEY MARKER NE RP" bears North 83°20' East, a distance of 25.27 feet.

A 5/8"x30" iron pin with 1 1/2" aluminum cap marked "BGB SURVEY MARKER SE RP" bears South 46°47' East, a distance of 40.34 feet. (On South bank of irrigation ditch)

A 5/8"x30" iron pin with 1 1/2" aluminum cap marked "BGB SURVEY MARKER SW RP" bears South 41°18' West, a distance of 34.56 feet. (On South bank of irrigation ditch)

A 5/8"x30" iron pin with 1 1/2" aluminum cap marked "BGB SURVEY MARKER NW RP" bears North 86°31' West, a distance of 39.13 feet.


I hereby certify that the corner was monumented on May 16, 2002. Witness: Greg T. Blackman Jr.

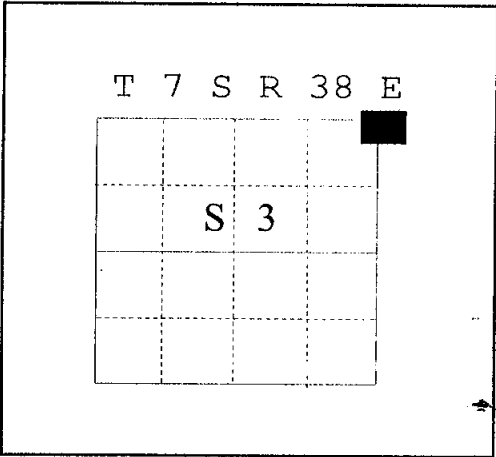

REGISTERED
PROFESSIONAL
LAND SURVEYOR

OREGON
July 17, 1986
RICK G. ROBINSON
2219

Renewal Date December 31, 2002

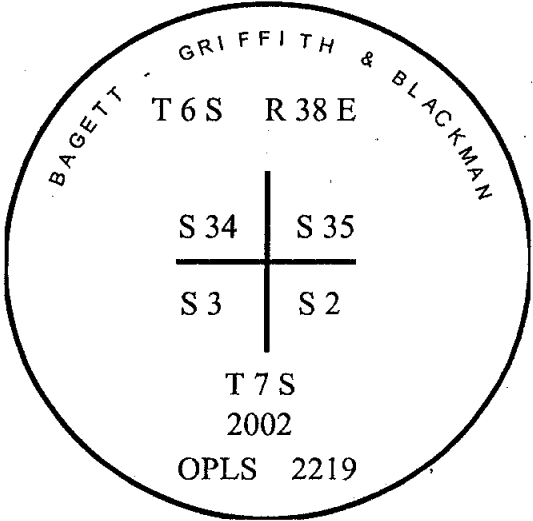

I used a Leica 530 GPS system with the Basis of Bearing being the same as Survey dated May 20, 2002 for Wes Williams in establishment of the new accessories. The distances are to the center of cap.

FILED MAY 22, 2002
BAKER COUNTY SURVEYOR
SURVEY NO. 6-38-24
7-38-77
CP # 80