


CERTIFIED RECORD OF LAND CORNER MONUMENTATION

HISTORY OF ORIGINAL CORNER ESTABLISHMENT:
Corner not previously established.

DESCRIPTION OF CORNER EVIDENCE FOUND:
NONE

See Survey dated May 20, 2002 for Wes Williams

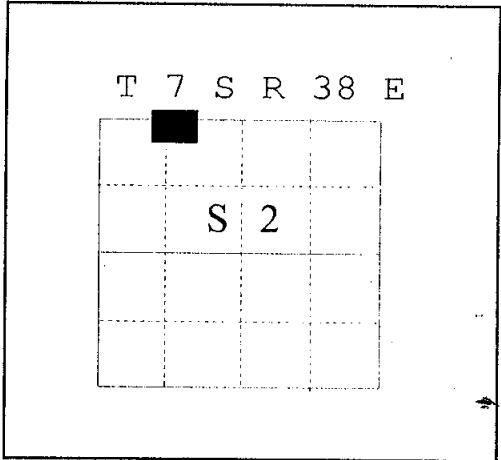

DESCRIPTION OF MONUMENT AND ACCESSORIES I ESTABLISHED
TO PERPETUATE THE ORIGINAL LOCATION OF THIS CORNER:



At a position determined by survey, I set a 2 ½"x 30" aluminum pipe with aluminum cap marked as shown below, 24" in the ground, from which;

NEW BEARING OBJECTS:

A 5/8"x30" iron pin with 1½" aluminum cap marked "BGB SURVEY MARKER SW RP" bears South 36°54' West, a distance of 48.14 feet.

A 5/8"x30" iron pin with 1½" aluminum cap marked "BGB SURVEY MARKER NW RP" bears North 58°58' West, a distance of 24.67 feet. (In South end of N-S Fence)

I hereby certify that the corner was monumented on May 16, 2002.
Witness: Greg T. Blackman Jr.

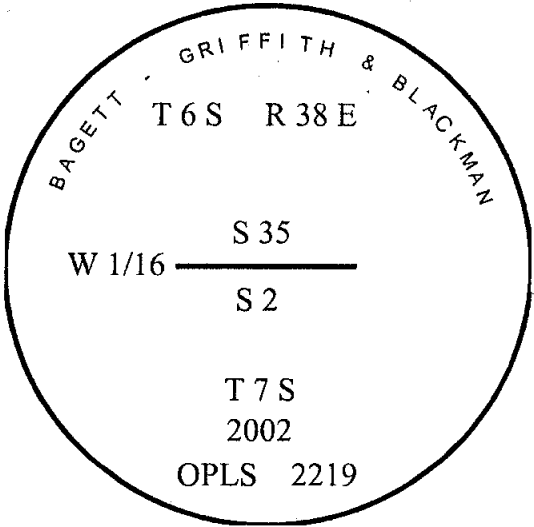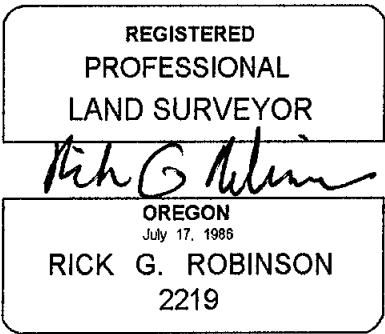

I used a Leica 530 GPS system with the Basis of Bearing being the same as Survey dated May 20, 2002 for Wes Williams in establishment of the new accessories. The distances are to the center of cap.

FILED MAY 22, 2002
BAKER COUNTY SURVEYOR
SURVEY NO. 6-38-25
7-38-78
CP # 81