

GOVERNMENT CORNER RECORD

Township 7S Range 38E Section 1 County BAKER

State OREGON Date NOVEMBER 21, 2003 Number A-25

Corner Designation : FOUND CORNER ACCEPTED AS THE NORTHEAST CORNER OF SECTION 1

Condition Report Only
 Not Found
 Renewed
 Surveyed In
 Referenced

Previous Renewals _____


Monument (s) Found: (Condition and Source)
FOUND BRASS CAP MONUMENT ON A 5/8" REBAR ACCEPTED AS THE NORTHEAST CORNER OF SECTION 1 AS PER COUNTY SURVEY NO. 7-38-65.

MONUMENT DETAIL

Found Set

Accessories Found:

NONE

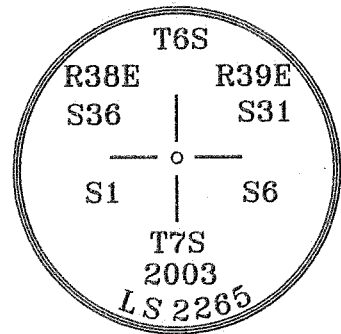

Monument & Accessories Set (Procedure and Description)

FOUND A 5/8" REBAR 0.90 BELOW ASPHALT IN GOOD CONDITION WITH BRASS CAP MONUMENT GONE. SET A 2" ALUM. CAP IN CONCRETE ABOVE REBAR. MONUMENT LOCATION VERIFIED AND RESET FROM CONSTRUCTION TIES MADE DURING THE RECONSTRUCTION OF ANTHONY LAKES HWY. TIES MADE TO CONTROL NETWORK FOR HWY. CONTROL AND TO TWO P.K. NAILS SET NORTHERLY OF MONUMENT PRIOR TO CONSTRUCTION. SET P.K. NAILS IN ALL FOUR QUADRANTS AS SHOWN BELOW.

<p style="text-align: center;"><u>Sketch of Monument, Accessories and General Area</u></p>	<p style="text-align: center;">Surveyor's Seal</p> <div style="border: 1px solid black; padding: 5px; text-align: center;"> <p>REGISTERED PROFESSIONAL LAND SURVEYOR</p> <p><i>Randy Scott</i></p> <p>OREGON JAN. 21, 1988 RANDY SCOTT 2265</p> </div> <p style="text-align: center;">RENEWAL DATE : 6-30-04</p> <p>Surveyors Address: 14550 S.W. Rock Creek Rd. Sheridan, OR 97378 Party Chief <u>L. KING</u> Notekeeper <u>L. KING</u> Witness(s) <u>C. KING</u> FIELD BOOK 0-199 PG. 123 JOB No. OR-03005</p> <p style="text-align: center;">COUNTY SURVEYOR RECORDING INFO</p> <p>Received <u>APRIL 21, 2004</u> Filed <u>APRIL 21, 2004</u> Survey No. <u>6-38-27</u> <u>7-38-84</u> <u>6-39-4</u> Drawing No. <u>7-39-51</u> Index No. <u>CP #109</u></p>
--	--