

GOVERNMENT CORNER RECORD

Township 7S Range 38E Section 1 County BAKER

State OREGON Date NOVEMBER 21, 2003 Number A-25

Corner Designation : FOUND CORNER ACCEPTED AS THE
NORTHEAST CORNER OF SECTION 1

Previous Renewals _____

Monument (s) Found: (Condition and Source)

FOUND BRASS CAP MONUMENT ON A 5/8" REBAR ACCEPTED AS
THE NORTHEAST CORNER OF SECTION 1 AS PER COUNTY
SURVEY NO. 7-38-65.

Accessories Found:

NONE



Monument & Accessories Set (Procedure and Description)

FOUND A 5/8" REBAR 0.90 BELOW ASPHALT IN GOOD CONDITION WITH BRASS CAP MONUMENT GONE. SET A
2" ALUM. CAP IN CONCRETE ABOVE REBAR. MONUMENT LOCATION VERIFIED AND RESET FROM CONSTRUCTION
TIES MADE DURING THE RECONSTRUCTION OF ANTHONY LAKES HWY. TIES MADE TO CONTROL NETWORK FOR
HWY. CONTROL AND TO TWO P.K. NAILS SET NORTHERLY OF MONUMENT PRIOR TO CONSTRUCTION. SET P.K.
NAILS IN ALL FOUR QUADRANTS AS SHOWN BELOW.

____ Condition Report Only
____ Not Found
☒ Renewed
____ Surveyed In
☒ Referenced

MONUMENT DETAIL

☒ Found ☒ Set

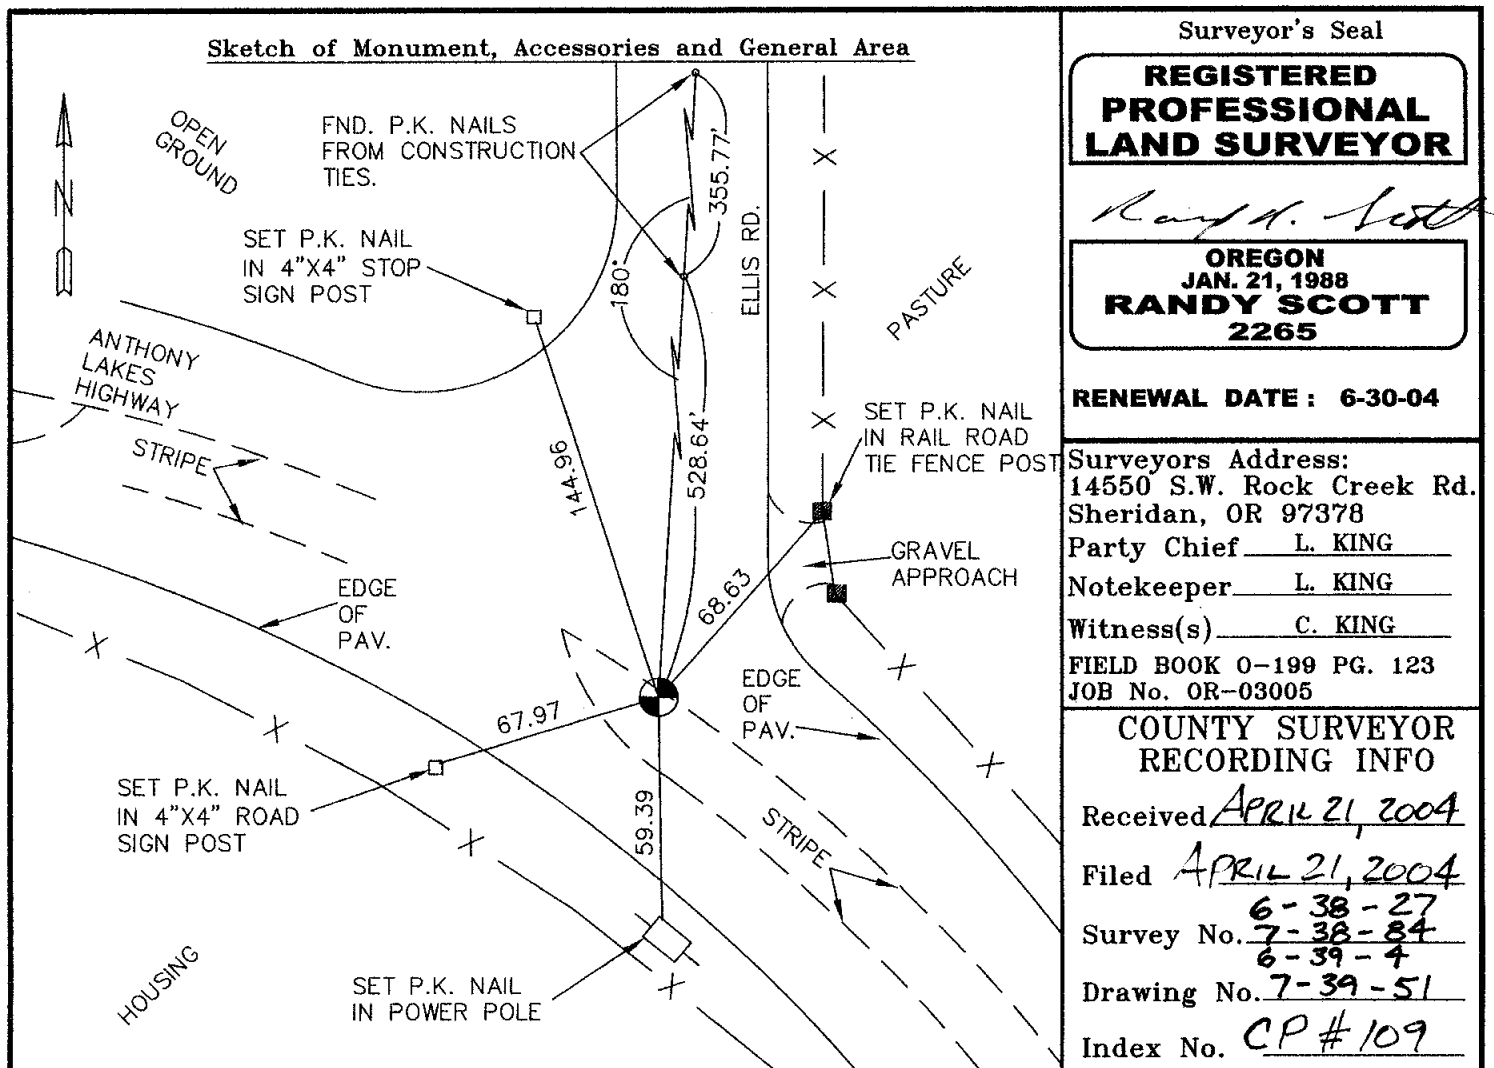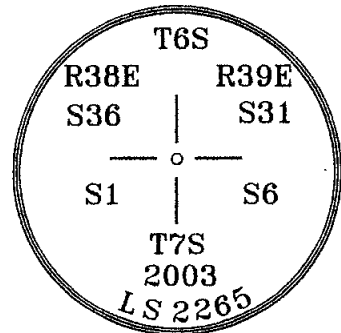

Surveyor's Seal

**REGISTERED
PROFESSIONAL
LAND SURVEYOR**

Randy D. Scott
**OREGON
JAN. 21, 1988
RANDY SCOTT
2265**

RENEWAL DATE: 6-30-04

Surveyors Address:
14550 S.W. Rock Creek Rd.
Sheridan, OR 97378
Party Chief L. KING
Notekeeper L. KING
Witness(s) C. KING
FIELD BOOK 0-199 PG. 123
JOB No. OR-03005

**COUNTY SURVEYOR
RECORDING INFO**

Received APRIL 21, 2004
Filed APRIL 21, 2004
Survey No. 6-38-27
7-38-84
6-39-4
Drawing No. 7-39-51
Index No. CP #109