CERTIFIED RECORD OF LAND CORNER MONUMENTATION

HISTORY OF ORIGINAL CORNER ESTABLISHED:

Corner originally established in GLO Contract No. 102, dated July 20, 1863, executed by Timothy Davenport. Surveyor General field notes state:

Set qr. sec post. Made mound of rock

DESCRIPTION OF CORNER EVIDENCE FOUND:

No original corner evidence remains. Several fence corners fall in the area. A railroad tie fence corner, from which fences bears North and West were attested by long term landowner to be the in the position of the original corner,

replacing a long standing split rail fence. Rails for original fence fall alongside.

T 6 S R 38 E Z-11

DESCRIPTION OF MONUMENT AND ACCESSORIES I ESTABLISHED TO PERPETUATE THE ORIGINAL LOCATION OF THIS CORNER:

At position determined by survey, I set a 2 1/2" x 30" aluminum pipe with a 3" aluminum cap, 27 inches in the ground, from which:

NEW BEARING OBJECTS:

A 15 inch Ponderosa Pine bears North 40° East, a distance of 43.95 feet, marked 1/4 S33 BT.

A 4 inch Ponderosa Pine bears South 55° East, a distance of 16.25 feet, marked 1/4 S4 BT.

An 8 inch Douglas Fir bears South $78\,^{\circ}$ West, a distance of 37.15 feet, marked 1/4 S4 BT.

A 22 inch Ponderosa Pine bears North, a distance of 7.5 feet, marked 1/4 S33 BT. Tree is used as a fence corner from which fences bears North, South and East.


Set steel fence post approx. 0.5 foot East.

I hereby certify that the corner was perpetuated on August 5, 2024.

REGISTERED
PROFESSIONAL
LAND SURVEYOR

OREGON
June 2, 2010
JEFFREY S. HSU
83571

Renewal Date: June 30, 2025

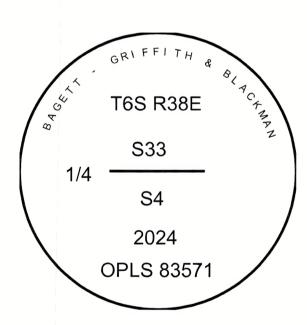

I use a tape and compass in the establishment of the new bearing objects. I use 14° East declination. Bearings are measured to a brass washer labeled "OPLS 83571" in the BT blaze at the base of the tree. Distances are to a 60D nail in the right side of the base of the center of the tree.

Z-11

BAKER COUNTY SURVEYOR
SURVEY MO 6-38-50