


- T-21 Quarter corner between Sections 25 and 26: GLO records state "set post for corner in mound of earth..". Set 5/8 inch x 30 inch rebar with plastic cap mkd. HANLEY ENGRG PLS 1206 in center of Baker County road on projected line of North-South running fence. Road has obliterated corner point. Road records indicate centerline and mid-section line are coincident.
- T-25 Quarter corner between Sections 25 and 30: GLO records state "set post in mound of rock". Found fence corner at this location, did not remonument this survey.
- V-17 Corner common to Sections 26, 27, 34 and 35: GLO records state "set post for corner to Sections 26, 27, 34 and 35 in mound of earth ...". Found a 3-way fence intersection. Fences run North, East and West. Point not remonumented this survey.
- V-19 Quarter corner between Sections 26 and 35: GLO records state "set post for corner in mound of earth..". Found 4-way fence intersection, did not remonument this survey.
- V-21 Corner common to Sections 25, 26, 35 and 36: GLO records state "set post for corner to Sections 25, 26, 35 and 36 in mound of earth...". Found 3-way fence intersection of fences running North, East and West, did not remonument this survey.
- V-23 Quarter corner common to Sections 25 and 36: GLO records state "set post for corner in mound of earth..". No evidence found. Point was established by single proportionate method between Southeast and Southwest section corners. Did not remonument this survey.
- V-25 Corner common to Sections 25, 30, 31 and 36: GLO records state "set post for corner to Sections 30, 31, 25 and 36". Found a 13 x 9 x 6 inches stone firmly set in ground at 3-way fence intersection with 5 grooves on North face and one groove on South face. Did not remonument this survey.

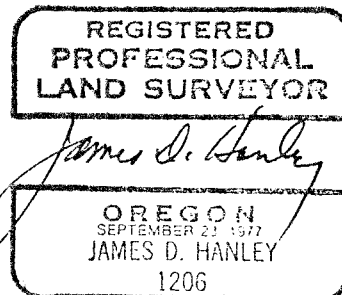

HANLEY ENGINEERING  
2043 MAIN STREET  
BAKER, OREGON