

**NARRATIVE**

This survey was performed for Farmers Home Administration for the purpose of identifying conservation easement boundaries on the Milton E. Miles property and preparing legal description of those lands.


The survey consisted of locating and/or reestablishing the original land survey corner monuments for the 4 Sections shown hereon, subdividing those sections into their aliquot parts and monumenting the Miles property corners.

The easement boundaries had been previously marked by others using temporary stakes and flagging. These marks were monumented as shown, and survey traverse was completed around the perimeters.

An additional map of survey is filed describing in more detail the corner monuments found and the manner by which missing corner markers were reestablished.

Additional GLO corner data is attached hereon as part of this narrative.

T.6 S., R.39 E., W.M.

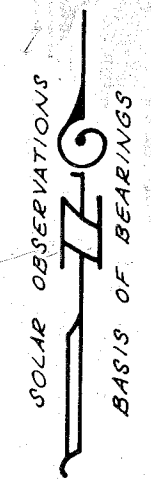


**LEGEND**

- Set 2 1/2" brass cap on 1/4" iron pipe w/ stone mound
- Set 3/8" x 30" rebar w/ plastic cap marked "HANLEY ENBERG PLS 1206"
- Found 3/4" iron pipe
- Existing fence line

**MAP OF SURVEY**  
**LEGAL BOUNDARY SITE SURVEY**  
**FOR CONSERVATION EASEMENT**  
 T.6 S., R.39 E., W.M., SECTIONS 23, 24, 25 & 26

FOR  
 FARMERS HOME ADMINISTRATION  
 PURCHASE ORDER NO: 00-0496-9-00101  
 MARCH-MAY, 1989

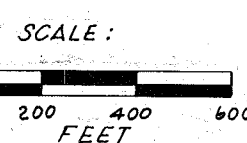

REGISTERED PROFESSIONAL LAND SURVEYOR  
 James D. Hanley  
 OREGON  
 JAMES D. HANLEY  
 1206

HANLEY ENGINEERING  
 2043 MAIN STREET  
 BAKER, OREGON

FILED June 22, 1989  
 BAKER COUNTY SURVEYOR  
 SURVEY NO. 6-39-2