


K: SOUTHEAST 1/16 CORNER SECTION 20:

MONUMENT SET 24" IN GROUND WITH MOUND OF STONE TO CAP. CAP MARKED:

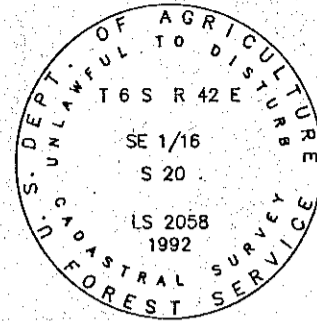


FROM WHICH LS2058 ACCESSORIES:

A PINE, 12" DIAM. BEARS N73°55'E, 9.42', SCRIBED SE1/16S20BT
A PINE, 10" DIAM. BEARS S24°46'E, 24.46', SCRIBED SE1/16S20BT

L: CENTER SOUTH 1/16 CORNER SECTION 20:

MONUMENT SET 25" IN GROUND WITH MOUND OF STONE TO CAP. CAP MARKED:

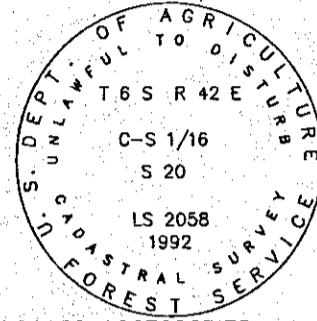


FROM WHICH LS2058 ACCESSORIES:

A FIR, 12" DIAM. BEARS N02°01'E, 72.62', SCRIBED C-S1/16S20BT
A FIR, 18" DIAM. BEARS N78°36'W, 21.71', SCRIBED C-S1/16S20BT

M: CORNER 1 ADOPTED ORPHAN - MS 938:

FOUND 1 1/4" PIPE IN A 30"x12" MOUND OF STONE. MONUMENT SET 24" IN GROUND AND BURIED FOUND PIPE TO WEST. CAP MARKED:

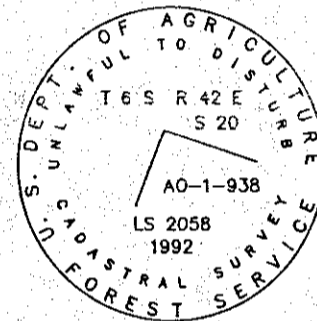


FROM WHICH MS-938 ACCESSORIES:

A PINE, 12" (14") DIAM. BEARS N65°51'E (N73'E), 19.81' (19'), BLAZE CLOSED
A PINE, 14" (14") DIAM. BEARS N68°15'W (N68°W) 4.40' (4'), BLAZE CLOSED

N: CORNER 2 ADOPTED ORPHAN - MS 938:

FOUND 1 1/4" PIPE AND STONE MARKED 2 AO 938 ON WEST FACE. MONUMENT SET 24" IN GROUND AND BURIED FOUND PIPE TO WEST. CAP MARKED:

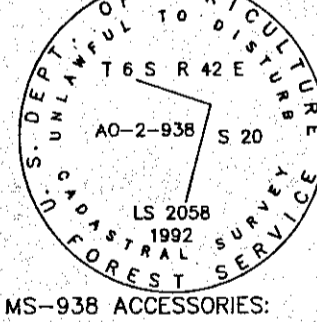


FROM WHICH MS-938 ACCESSORIES:

A FIR, 12" (12") DIAM. BEARS S53°49'W (S57°W), 11.73' (11.3'), BLAZE CLOSED
A FIR, 7" (6") DIAM. BEARS S89°02'E (S85°E) 9.98' (9.9'), BLAZE CLOSED

O: CORNER 3 ADOPTED ORPHAN - MS 938: CORNER 3 NEGLECTED - MS 938:

FOUND A 1" PIPE AND CAP ALONGSIDE MARKED STONE. SET MONUMENT 23" IN GROUND AND BURIED FOUND PIPE TO WEST. BUILD MOUND OF STONE TO CAP MARKED:

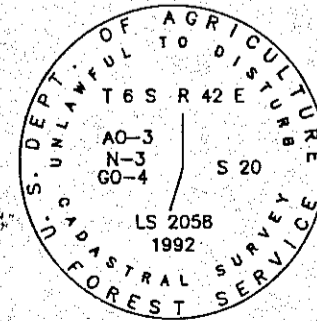


FROM WHICH MS-938 ACCESSORIES:

A PINE, 10" (8") DIAM. BEARS S88°42'E (S60°E), 13.27' (13.1'), BLAZE CLOSED
A PINE, 8" (8") DIAM. BEARS S17°27'W (S20°W) 32.93' (33'), BLAZE CLOSED

P: CORNER 4 ADOPTED ORPHAN - MS 938: CORNER 2 NEGLECTED - MS 938:

FOUND 1 1/4" PIPE IN A 30"x12" MOUND OF STONE. MONUMENT SET 24" IN GROUND AND OVER FOUND PIPE. CAP MARKED:

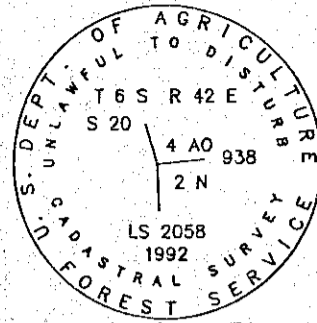

FROM WHICH MS-938 ACCESSORIES:


A PINE, 24" (12") DIAM. BEARS S47°26'E (S50°E), 76.74' (76.9'), BLAZE CLOSED
A PINE, 38" (8") DIAM. BEARS N29°22'W (N25°E) 63.19' (58.3'), BLAZE CLOSED

FROM WHICH LS2058 ACCESSORIES:

A PINE, 10" DIAM. BEARS S19°39'W, 81.23', SCRIBED N2938 BT

Q: CORNER 1 NEGLECTED - MS 938:

FOUND 1 1/4" PIPE IN A 24"x12" MOUND OF STONE. MONUMENT SET 24" IN GROUND AND BURIED FOUND PIPE ALONGSIDE. CAP MARKED:

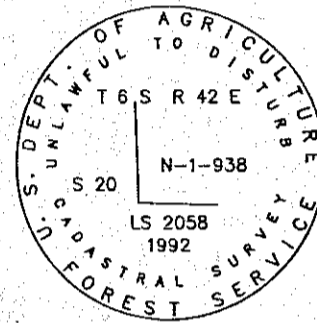

FROM WHICH MS-938 ACCESSORIES:


A PINE, 12" (10") DIAM. BEARS S70°11'W (S68°W), 28.52' (29'), BLAZE CLOSED
A PINE, 10" (8") DIAM. BEARS S86°10'W (S85°W) 20.29' (20.2'), BLAZE CLOSED

FROM WHICH LS2058 ACCESSORIES:

A PINE, 8" DIAM. BEARS S08°05'E, 4.07', SCRIBED N1938BT

R: CORNER 4 NEGLECTED - MS 938: CORNER 3 GOLDIE - MS 938:

NO EVIDENCE OF ORIGINAL MONUMENT FOUND. POSITION ESTABLISHED FROM FOUND ORIGINAL BEARING TREES. SET MONUMENT 6" IN GROUND WITH MOUND OF STONE TO CAP. CAP MARKED:

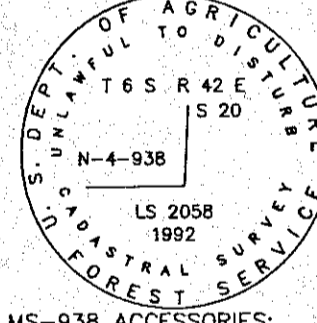

FROM WHICH MS-938 ACCESSORIES:


A FIR STUMP, 21" (24") DIAM. BEARS N24°15'W (N30°W), 12.87' (13.1'), SCRIBED 4N3G938BT
A PINE, 15" IN DIAM. BEARS S35°01'E, 23.01', SCRIBED 4NG3938 - NOT IN ORIGINAL NOTES

FROM WHICH LS2058 ACCESSORIES:

A FIR, 10" DIAM. BEARS S63°01'W, 40.36', SCRIBED N4-G3-938BT

S: CORNER 1 LUCKY BREAK - MS 938:

FOUND 1 1/4" PIPE IN A 30"x12" MOUND OF STONE. MONUMENT SET 20" IN GROUND AND BURIED FOUND PIPE TO WEST. CAP MARKED:

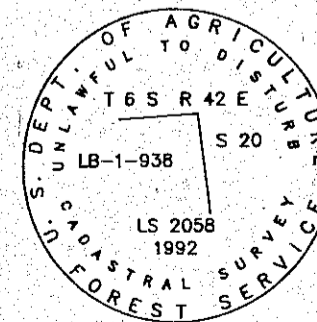


FROM WHICH MS-938 ACCESSORIES:

A PINE, 12" (6") DIAM. BEARS S52°59'W (N65°E), 15.15' (15.5'), BLAZE CLOSED
A PINE, 12" (6") DIAM. BEARS N60°49'E (S55°W) 13.24' (13.5'), BLAZE CLOSED

T: CORNER 2 LUCKY BREAK - MS 938:

FOUND 1 1/4" PIPE IN A 24"x12" MOUND OF STONE. MONUMENT SET 15" IN GROUND AND BURIED FOUND PIPE TO WEST. CAP MARKED:

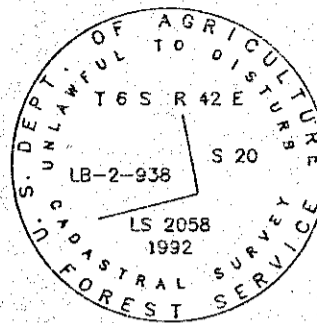


FROM WHICH MS-938 ACCESSORIES:

A PINE, 14" (8") DIAM. BEARS N51°30'E (N56°E), 25.09' (25.2'), BLAZE CLOSED
A PINE, 7" DIAM. BEARS S04°12'E, 32.58'

U: CORNER 3 LUCKY BREAK - MS 938:

FOUND 1 1/4" PIPE IN A 18"x6" MOUND OF STONE. MONUMENT SET 22" IN GROUND AND BURIED FOUND PIPE TO WEST. CAP MARKED:

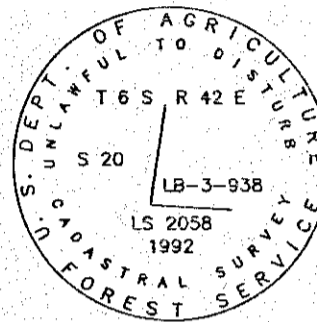

FROM WHICH MS-938 ACCESSORIES:


A PINE STUMP, 16" (18") DIAM. BEARS N34°36'E (N40°E), 6.18' (6.9'), BLAZE OPEN SCRIBED 3LB938BT
A FIR STUMP, 13" (6") DIAM. BEARS S15°51'E (S23°E) 12.98' (13'), BLAZE VISIBLE

FROM WHICH LS2058 ACCESSORIES:

A PINE, 24" DIAM. BEARS N32°52'W, 22.94', SCRIBED LB3938BT
A FIR, 23" DIAM. BEARS S29°45'W, 33.39', SCRIBED LB3938BT


V: CORNER 2 GOLDIE - MS 938:

FOUND 1 1/4" PIPE 2.6" ABOVE GROUND. NO MOUND OF STONE. MONUMENT SET 24" IN GROUND AND BURIED FOUND PIPE TO WEST. CAP MARKED:

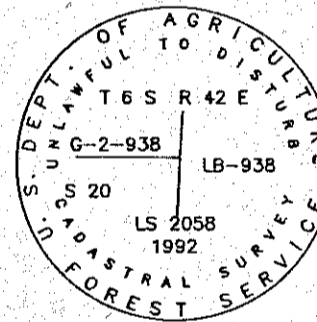

W: CORNER 4 LUCKY BREAK - MS 938: CORNER 3 ZENA BELL - MS 938:

FOUND 1 1/4" PIPE IN A 24" MOUND OF STONE. MONUMENT SET 24" IN GROUND, BURIED FOUND PIPE ALONGSIDE AND BUILD MOUND OF STONE TO CAP. CAP MARKED:

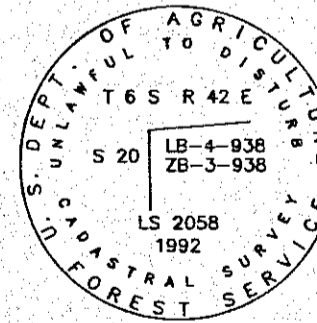


FROM WHICH MS-938 ACCESSORIES:

A FIR, 19" (14") DIAM. BEARS N12°39'W (N15°W), 31.18' (32.7'), BLAZE CLOSED
A FIR, 17" (14") DIAM. BEARS N42°57'E (N70°E) 40.42' (40.8'), BLAZE OPEN - SCRIBING NOT VISIBLE

X: CORNER 3 MORNING - MS 938:

FOUND 1 1/4" PIPE. MONUMENT SET 20" IN GROUND WITH MOUND OF STONE TO CAP. BURIED FOUND PIPE TO WEST. CAP MARKED:

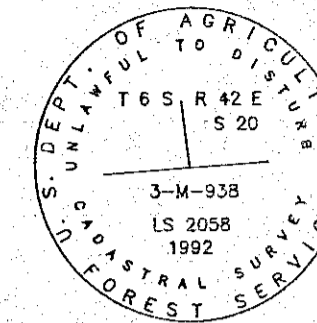

FROM WHICH MS-938 ACCESSORIES:


A PINE STUMP, 10" (12") DIAM. BEARS N08°33'E (N16°E), 7.54' (6.8'), BLAZE OPEN SCRIBED 3M938BT
A PINE STUMP, 16" DIAM. BEARS N44°00'W, 50.61', SCRIBED 3M938BT - NO RECORD ON THIS B.T.

FROM WHICH LS2058 ACCESSORIES:

A PINE, 10" DIAM. BEARS S19°27'E, 29.72', SCRIBED 3M938BT
A FIR, 9" DIAM. BEARS N60°14'E, 38.37', SCRIBED 3M938BT

Y: 1/4 CORNER TO SECTIONS 16 & 21:

NO EVIDENCE OF ORIGINAL MONUMENT OR ACCESSORIES FOUND. MONUMENT SET AT PROPORTIONAL POSITION, 24" IN GROUND WITH MOUND OF STONE TO CAP. CAP MARKED:

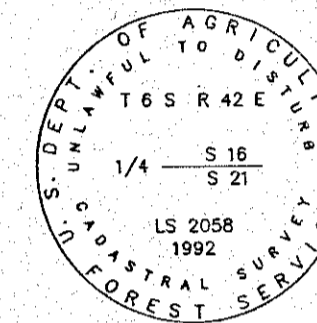


FROM WHICH LS2058 ACCESSORIES:

A FIR, 18" DIAM. BEARS N41°E, 40.64', SCRIBED 1/4S16BT
A TAM, 12" DIAM. BEARS N70°E, 44.38', SCRIBED 1/4S16BT
A FIR, 16" DIAM. BEARS S48°15'E, 68.58', SCRIBED 1/4S21BT
A FIR, 12" DIAM. BEARS S58°45'W, 9.60', SCRIBED 1/4S21BT

Z: CORNER TO SECTIONS 15, 16, 21, & 22:

SET MONUMENT 2" IN GROUND AT LOCATION OF FOUND SMALL MOUND OF STONE. CAP MARKED:

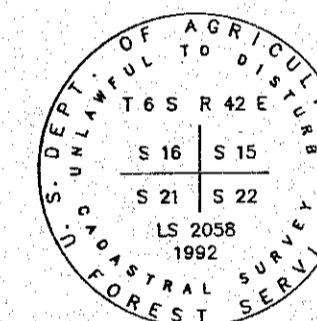


FROM WHICH G.L.O. ACCESSORIES:

A DEAD AND DOWN PINE, 32" DIAM. [10"], BEARS S45°20'W [S47°W], 50.11' [49.5'], SCRIBING NOT VISIBLE
A PINE STUMP, 24" [24"] DIAM. BEARS S65°28'E [S72°E], 134.92' [130.7'], BLAZE NOT VISIBLE
A FIR STUMP, 24" [5"] DIAM. BEARS N28°E [N28°E] 74.6' [74.6']

FROM WHICH LS2058 ACCESSORIES:


A PINE, 11" DIAM. BEARS N38°26'W, 56.97', SCRIBED T6SR42ES16BT
A FIR, 13" DIAM. BEARS S56°22'W, 22.74', SCRIBED T6SR42ES21BT
A PINE, 19" DIAM. BEARS S59°55'E, 60.61', SCRIBED T6SR42ES22BT
A FIR, 18" DIAM. BEARS N28°09'E, 52.96', SCRIBED T6SR42ES15BT

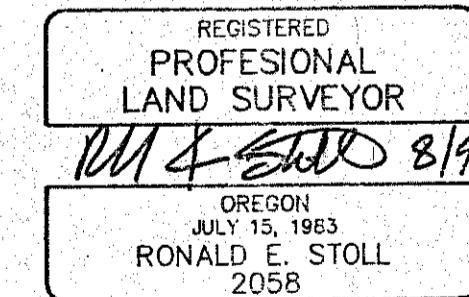

RONALD E. STOLL, R.L.S. 2058

AA: 1/4 CORNER TO SECTIONS 21 & 22:

NO EVIDENCE OF ORIGINAL MONUMENT OR ACCESSORIES FOUND. SET MONUMENT 22" IN GROUND AT PROPORTIONAL POSITION WITH MOUND OF STONE TO CAP. CAP MARKED:

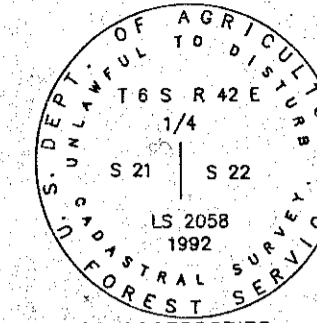


FROM WHICH LS2058 ACCESSORIES:

A PINE, 12" DIAM. BEARS N35°25'W, 33.56', SCRIBED 1/4S21BT
A PINE, 8" DIAM. BEARS N71°00'E, 30.37', SCRIBED 1/4S22BT
A PINE, 14" DIAM. BEARS S39°15'E, 58.51', SCRIBED 1/4S22BT
A PINE, 12" DIAM. BEARS S37°00'W, 50.80', SCRIBED 1/4S21BT

BB: CORNER TO SECTIONS 21, 22, 27, & 28:

NO EVIDENCE OF ORIGINAL MONUMENT FOUND, SET MONUMENT 20" IN GROUND AT INTERSECTION RECORD DISTANCES FROM ORIGINAL BEARING TREES TO NORTHWEST AND SOUTHWEST. CAP MARKED:

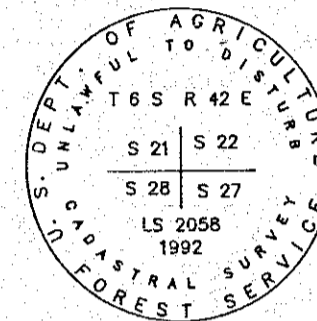

FROM WHICH G.L.O. ACCESSORIES:


A PINE, 17" DIAM., BEARS N10°02'W, 44.79', CLOSED BLAZE
A PINE, 12" [6"] DIAM., BEARS N28°36'E [N23°E], 28.05' [28.4'], BLAZE VISIBLE AND OPEN
A PINE 18" [12"] DIAM. BEARS S58°51'W [S70°W] 12.14' [12.5'], BLAZE OPEN BUT ILLEGIBLE

FROM WHICH LS2058 ACCESSORIES:

A PINE, 13" DIAM. BEARS S60°44'E, 31.38', SCRIBED T6SR42ES27BT

CC: 1/4 CORNER TO SECTIONS 21 & 28:

NO EVIDENCE OF ORIGINAL MONUMENT FOUND. SET MONUMENT 20" IN GROUND AT PROPORTIONAL POSITION, WITH MOUND OF STONE TO CAP.

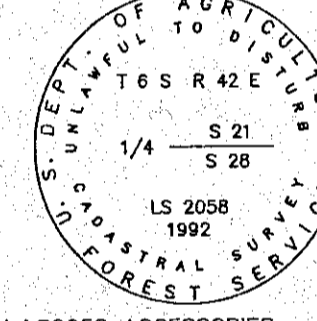


FROM WHICH LS2058 ACCESSORIES:

A TAM., 10" DIAM. BEARS N45°02'W, 11.42', SCRIBED 1/4S21BT
A FIR, 6" DIAM. BEARS S78°45'W, 19.38', SCRIBED 1/4S28BT
A TAM., 6" DIAM. BEARS S19°37'E, 12.65', SCRIBED 1/4S28BT
A TAM., 9" DIAM. BEARS N63°20'E, 6.03', SCRIBED 1/4S21BT

DD: CENTER 1/4 CORNER TO SECTION 21:

SET MONUMENT 18" IN GROUND WITH MOUND OF STONE TO CAP. CAP MARKED:

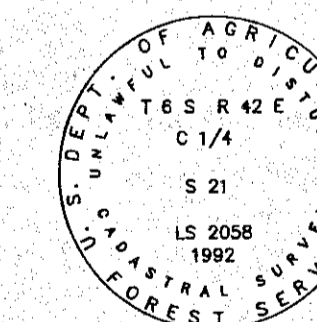

FROM WHICH LS2058 ACCESSORIES:

A TAM., 21" DIAM. BEARS N14°59'W, 79.60', SCRIBED C1/4S21BT
A TAM., 22" DIAM. BEARS N80°02'E 14.47', SCRIBED C1/4S21BT
A PINE, 14" DIAM. BEARS S19°37'E, 45.90', SCRIBED C1/4S21BT
A PINE, 15" DIAM. BEARS S71°30'W, 62.08', SCRIBED C1/4S21BT

JOB NO. 1210-691-OR
CONTRACT NO. 53-04M3-1-0113
SHEET 5 OF 5

NOTES

BEARINGS TO BEARING TREES WERE TAKEN TO A NAIL AND BRASS TAG, MARKED LS 2058, PLACED AT THE BASE OF THE FRONT FACE OF THE TREE OR ABOVE THE "B" IN "BT" IN THE BLAZE. DISTANCES WERE TAKEN TO 16d GALVANIZED NAIL IN THE SIDE CENTER BASE OF THE BEARING TREES.

MONUMENT = A 3" DIAM. U.S.F.S. ALUMINUM CAPPED PIPE, 30" LONG, WITH MAGNET

- [] RECORD BEARING AND/OR DISTANCE, G-L-O, 1883
- () RECORD BEARING AND/OR DISTANCE, MS 938, 1955
- { } RECORD BEARING AND/OR DISTANCE, LS1206

A PORTION OF
SECTIONS 20 AND 21
T 6 S R 42 E W.M.
BAKER COUNTY, OREGON

RECORD OF SURVEY
RES LAND SURVEYS, INC. 8335 PLACITA DADIVOSO TUCSON, ARIZONA 85704

FILED May 26, 1993

BAKER COUNTY SURVEYOR

SURVEY NO. 6-42-2 (5 sheets)