

RECORD OF LAND CORNER MONUMENTATION

SOUTH 1/4 CORNER SECTION 32, T. 6 S., R. 42 E., W.M.

ORIGINALLY ESTABLISHED BY: William B. Barr, U.S. Deputy Surveyor

CONTRACT NUMBER: 355

CONTRACT DATE: June 14, 1880

30	29		29	28
31	32		32	33
31	32		32	33
6	5		5	4

ORIGINAL DESCRIPTION: Planted Basalt Rock 15x10x6 according to instructions for 1/4 sec. corner. Raised mound of rock

EVIDENCE FOUND: Found stone 14"x9"x5" marked 1/4 on the top of the stone, in a loose mound of stones in a dilapidated rock jack along an old down east-west running fence. Also found an old National Forest boundary sign and Forest Service K-tag buried 5 inches below ground in the center of the mound of stones. The K-tag is marked for the corner, Bearing = 0°00', Distance = 0.00, dated April 8, 1964 and initialed by JHH and DRM. This location is harmoniously related to other found corners in the area, and indicates reliance over time (at least 58 years). I accept the center of the mound of stones as the best available evidence of the original 1/4 corner.


DESCRIPTION OF MONUMENTS AND ACCESSORIES SET AND METHODS USED:

In the center of the mound of stones, I set a standard USFS 2½"x30" aluminum pipe with attached ¾" aluminum cap, 20" in the ground. Raised a 5 ft. diameter mound of stone around the monument to top of cap. Cap is marked as shown below.

From which, I SET NEW REFERENCE POINTS:

- ▶ A 5/8"x 24" iron pin bears N.45°39'E., 53.95 ft., with attached 2" aluminum cap marked *RP 1 2022 PLS 69454*
- ▶ A 5/8"x 24" iron pin bears S.44°46'E., 14.14 ft., with attached 2" aluminum cap marked *RP 2 2022 PLS 69454*
- ▶ A 5/8"x 24" iron pin bears S.44°15'W., 13.61 ft., with attached 2" aluminum cap marked *RP 3 2022 PLS 69454*
- ▶ A 5/8"x 24" iron pin bears N.45°15'W., 19.81 ft., with attached 2" aluminum cap marked *RP 4 2022 PLS 69454*

CORNER MONUMENT
MARKED:

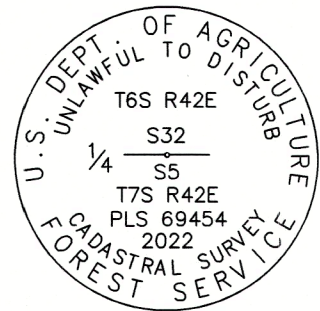

Deposit marked stone inverted, with K-tag and boundary sign Northeast and alongside the pipe. Used RTK GPS to measure accessories. Bearings are geodetic, derived by GPS observation at the corner. Set an aluminum guard post East, 3.8 feet with USFS 54-9 sign attached.


RESTORATION BY, STAMP AND DATE:

Work Performed August 10, 2022 by:

Jason L. Hatfield, PLS
Daniel B. Lee

USDA FOREST SERVICE
NORTHEAST OREGON LAND ZONE
1550 Dewey Avenue, Suite A
Baker City, OR 97814
(541) 523-1283

FILED December 14, 2022
BAKER COUNTY SURVEYOR
SURVEY NO. 6-42-6
7-42-22

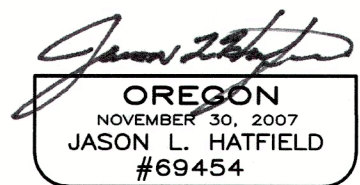

EXPIRES: 6/30/2023