

Index File No. X-17

CORNER RECORD (SEARCH)

Tract or Survey No. \_\_\_\_\_

Cor. No. E 1/4 COR. SEC. 34


T 6 S R. 13 E

R.D. UNION County Paker

Merid. Willamette

N.F. Wallowa-Whitman State Oregon

CORNER DIAGRAM

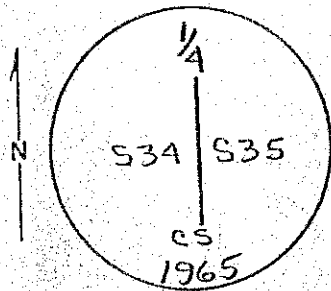

DESCRIBE CORNER MONUMENT FOUND

None, original monument was wood post.

DESCRIBE BEARING TREES OR OTHER OFFICIAL ACCESSORIES FOUND

Found rotten snag B.T. ( 7" fir ) for sec. 35

PHOTO IDENTIFICATION DATA

Photo No. \_\_\_\_\_  
 Filed At. \_\_\_\_\_  
 Object Ident. \_\_\_\_\_  
 Ident. By \_\_\_\_\_  
 Signature \_\_\_\_\_

DESCRIBE CORNER LOCATION RELATIVE TO NEAR-BY FEATURES, ALSO HOW TO REACH CORNER

Across Eagle Creek from Eagle Creek Road between Skookum Creek and Dixie Creek.

PLANE COORDINATE POSITION DATA

State \_\_\_\_\_ Zone \_\_\_\_\_  
 X \_\_\_\_\_  
 Y \_\_\_\_\_  
 Estab. By \_\_\_\_\_  
 Agency \_\_\_\_\_

Signature

Title

Division

Headquarters

Date

7100-52  
REV. 65 5

CORNER RECORD (PERPETUATION)

MONUMENT: DESCRIBE NEW MONUMENT SET, OR WORK DONE TO PRESERVE EXISTING MONUMENT

Set 1-inch galvanized pipe with 2-inch aluminum cap marked as shown

ACCESSORIES DESCRIBE NEW BT'S WITNESS OBJECTS ETC. ESTABLISHED, OR WORK DONE TO PRESERVE EXISTING EVIDENCE


None

Work Done By J. D. Hanley Title Engineer Date 8-65 State Registration No. 2808  
 or Agency Oregon P.E.

Certified Cor. Record Prepared ? Yes No Filed At: \_\_\_\_\_

REMARKS

SURVEY NO. 6-43-2

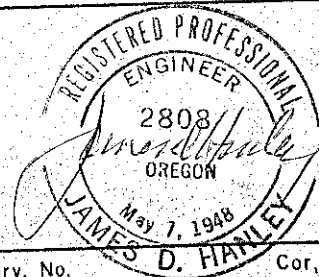

Index File No. \_\_\_\_\_

T. \_\_\_\_\_

R. \_\_\_\_\_

M. \_\_\_\_\_

Tract or Surv. No. \_\_\_\_\_

Cor. \_\_\_\_\_