


Index File No. 7-13 CORNER RECORD (SEARCH) Tract or Survey No. \_\_\_\_\_ Cor. SW COR. SEC. 27

T 6 S R. 13 E R.D. UNION County Baker  
 Merid. Willamette N.F. Wallowa-Whitman State Oregon

CORNER DIAGRAM DESCRIBE CORNER MONUMENT FOUND

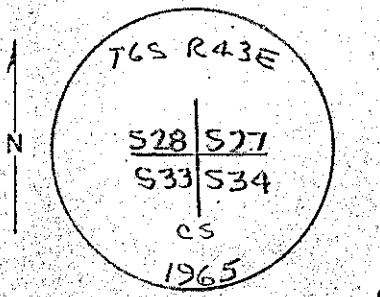

Found stone with  $\dagger$  on top of the stone

PHOTO IDENTIFICATION DATA

Photo No. \_\_\_\_\_  
 Filed At. \_\_\_\_\_  
 Object Ident. \_\_\_\_\_  
 Ident. By \_\_\_\_\_  
*Signature*

DESCRIBE BEARING TREES OR OTHER OFFICIAL ACCESSORIES FOUND

Found 3 B.T.'s.

PLANE COORDINATE POSITION DATA

State \_\_\_\_\_ Zone \_\_\_\_\_  
 X \_\_\_\_\_  
 Y \_\_\_\_\_  
 Estab. By \_\_\_\_\_  
*Agency*

DESCRIBE CORNER LOCATION RELATIVE TO NEAR-BY FEATURES, ALSO HOW TO REACH CORNER

South of Eagle Creek. Forest Service cruiser tag alongside Eagle Creek Road.

Signature \_\_\_\_\_ Title \_\_\_\_\_ Division \_\_\_\_\_ Headquarters \_\_\_\_\_ Date \_\_\_\_\_ 7100-52 REV. 65 5

CORNER RECORD (PERPETUATION)

MONUMENT: DESCRIBE NEW MONUMENT SET, OR WORK DONE TO PRESERVE EXISTING MONUMENT

Set 1-inch galvanized pipe with 2-inch aluminum cap alongside stone, and marked as shown.

ACCESSORIES: DESCRIBE NEW BT'S WITNESS OBJECTS ETC. ESTABLISHED, OR WORK DONE TO PRESERVE EXISTING EVIDENCE

None

Work Done By J. D. Hanley Title Engineer Date 8-65 State Registration No. or Agency Oregon P.E. 2808

Certified Cor. Record Prepared? Yes  No  Filed At: \_\_\_\_\_ Date \_\_\_\_\_

REMARKS

6-43-4



Index File No. \_\_\_\_\_ T. \_\_\_\_\_ R. \_\_\_\_\_ M. \_\_\_\_\_ Tract or Surv. No. \_\_\_\_\_