


Index File No. X-21 CORNER RECORD (SEARCH) Tract or Survey No. E 1/4 COR. SEC. 35
 T. 6 S R. 43 E R.D. UNION County Baker
 Merid. Willamette N.F. Wallowa-Whitman State Oregon

CORNER DIAGRAM

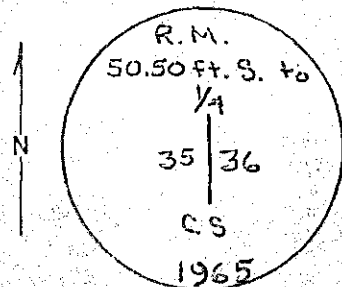

DESCRIBE CORNER MONUMENT FOUND

None

DESCRIBE BEARING TREES OR OTHER OFFICIAL ACCESSORIES FOUND

None

PHOTO IDENTIFICATION DATA

Photo No. _____
 Filed At. _____
 Object Ident. _____
 Ident. By _____
 Signature _____

DESCRIBE CORNER LOCATION RELATIVE TO NEAR-BY FEATURES, ALSO HOW TO REACH CORNER

Reference monument is north of Eagle Creek Road.

PLANE COORDINATE POSITION DATA

State _____ Zone _____
 X _____
 Y _____
 Estab. By _____
 Agency _____

Signature

Title

Division

Headquarters

Date

7100-52

REV. 65 5


CORNER RECORD (PERPETUATION)

MONUMENT: DESCRIBE NEW MONUMENT SET, OR WORK DONE TO PRESERVE EXISTING MONUMENT

Set 1-inch galvanized pipe with 2-inch aluminum cap marked as shown.
 50.50 ft. north of true $\frac{1}{4}$ corner location as reference monument.

ACCESSORIES: DESCRIBE NEW B.T.'S WITNESS OBJECTS ETC. ESTABLISHED, OR WORK DONE TO PRESERVE EXISTING EVIDENCE

None

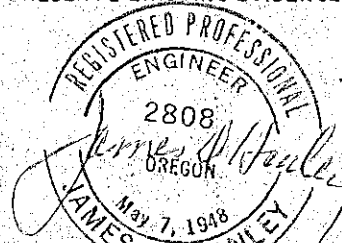

Work Done By J. D. Hanley Title Engineer Date 9-65 State Registration No. 2808
 or Agency Oregon P.E. 2808
 Certified Cor. Record Prepared? Yes No Filed At: _____ Date _____

REMARKS

Don Riggle, resident, pointed to location of two B.T. destroyed by Forest Service during road construction. The $\frac{1}{4}$ corner location determined from field notes ties to B.T.'s, and reference monument established 50.50 ft. north.

SURVEY NO. 6-43-5

Index File No. _____ T. _____ R. _____ M. _____ Tract or Surv. No. _____ Cor. _____