


P-9160-2
Nov. 1964

UNITED STATES
DEPARTMENT OF THE INTERIOR
BUREAU OF LAND MANAGEMENT

TOWNSHIP DIAGRAM

SCALE: 1 INCH = 1 MILE

TOWNSHIP 6 South, RANGE 43 East, Willamette MER.
STATE Oregon

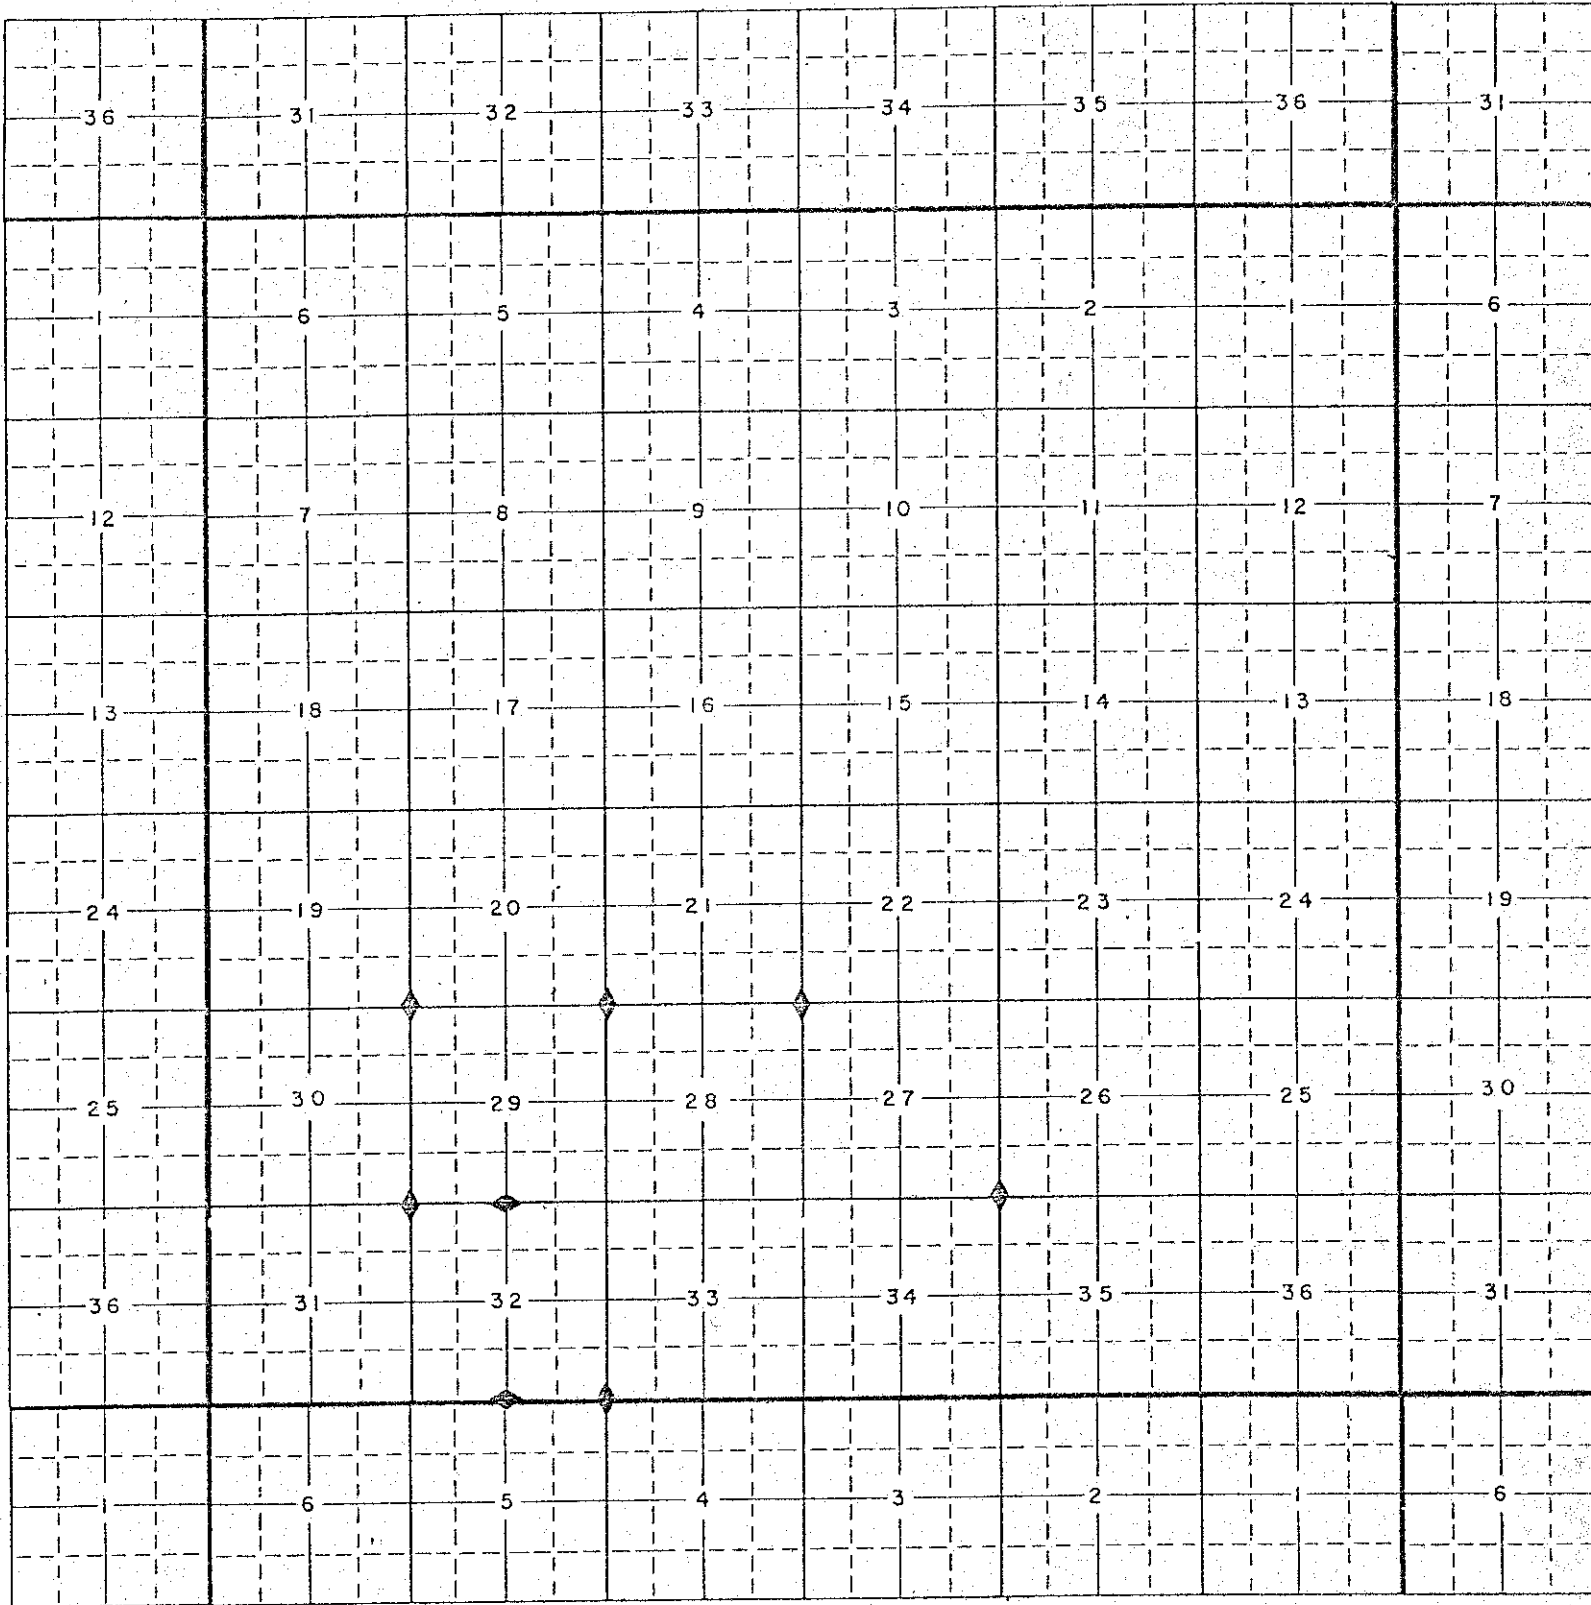

Wallowa-Witman National Forest, Region 6

Baker County

◆ Corners re-monumented 1975

FILED 12 10 75

BAKER COUNTY SURVEYOR
SURVEY NO. 6-43-8