


CERTIFIED RECORD OF LAND CORNER MONUMENTATION

History of original corner establishment: The corner was originally established by W. B. Barr under Contract No. 503 in July, 1884. The original notes call for a 4" long by 4" diameter post set 24" in the ground from which:

An 8" Tamarack bears N 60° E 14 LKS marked 1/4 S BT.
A 12" Tamarack bears S 75° E 72 LKS marked 1/4 S BT.

No record of subsequent re-monumentation found in County Records.

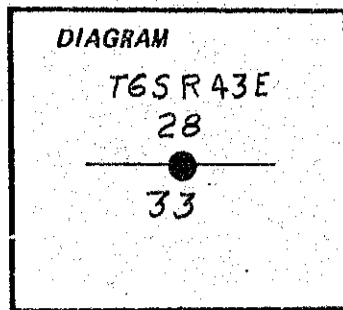

Description of corner evidence found:

None.

After a thorough search I set the corner by single proportion measurement between the found Southwest and Southeast corners of Section 33.

Description of monument and accessories I established to perpetuate the original location of this corner: At the calculated corner position I set a 2" x 30" iron pipe with brass cap marked:


Set monument 24" in the ground with a mound of earth from which:

A 17" Spruce bears N 38° W for 21.8 feet, scribed 1/4 S28 BT.

A 19" Red Fir bears S 57 1/2° E for 67.2 feet, scribed 1/4 S33 BT.

Both BT's have a lower blaze scribed BT with a brass washer stamped PLS 1106 nailed flush. Attached signs 54-3 and painted a red ring around each BT.

Set a steel fence post with sign 54-9 attached near the monument.

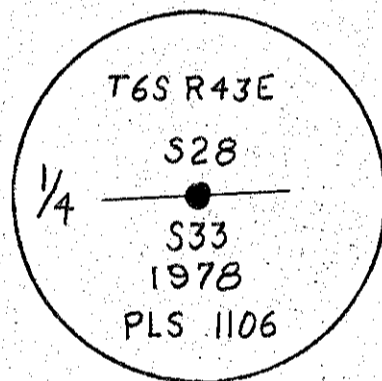

Witness: Les Wilson

Used magnetic compass with 20 1/2° E declination and measured to center of root crown on BT's with steel tape.

REGISTERED
PROFESSIONAL
LAND SURVEYOR

William R. Wells

OREGON
JULY 22, 1977
WILLIAM R. WELLS
1106

11-1-78

Office of..... County of.....

State of..... I hereby certify that the within instrument was filed in this office for record on the..... day of....., 19.....

..... by..... (COUNTY OFFICIAL) (DEPUTY)